T.9S.,R.2W.,W.M.

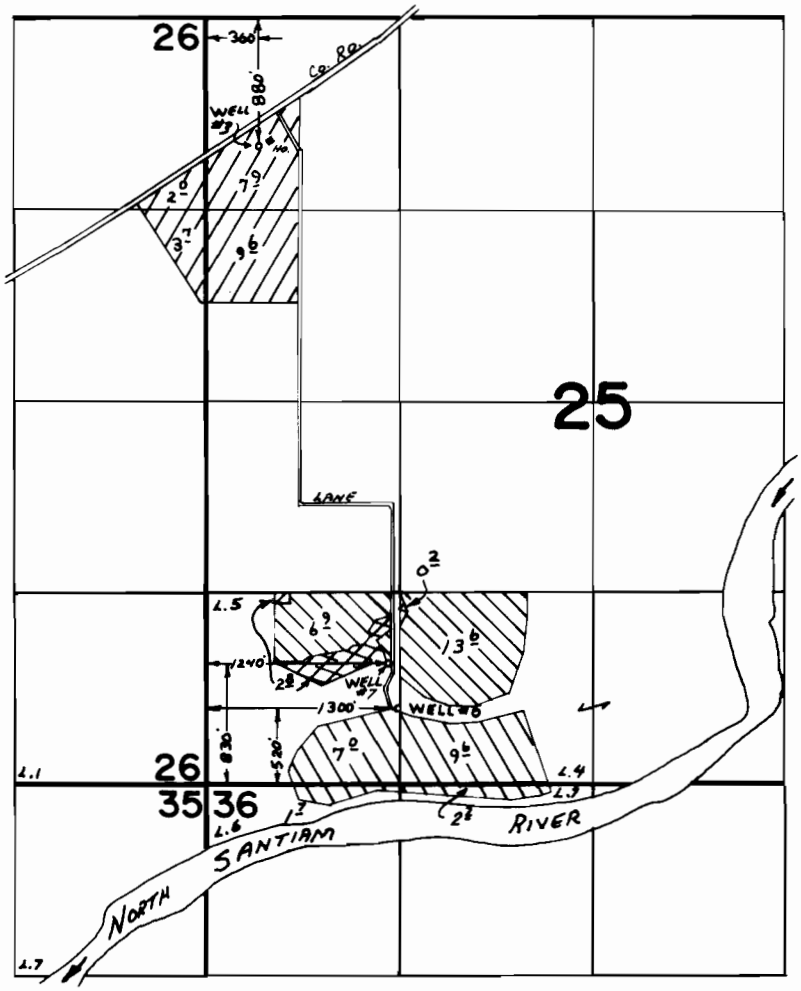

FINAL PROOF SURVEY

UNDER

G-6117 G-5791 -
G-6118 G-5792 -
Application No. G-6119 Permit No. G-5793 -

NO PERMIT FOR THIS LAND -

IN NAME OF

LOUIS SCOFIELD

Surveyed SEPT. 7 1976, by L. TOLL

DFN-311-60