


T.9S.,R.3W.,W.M.

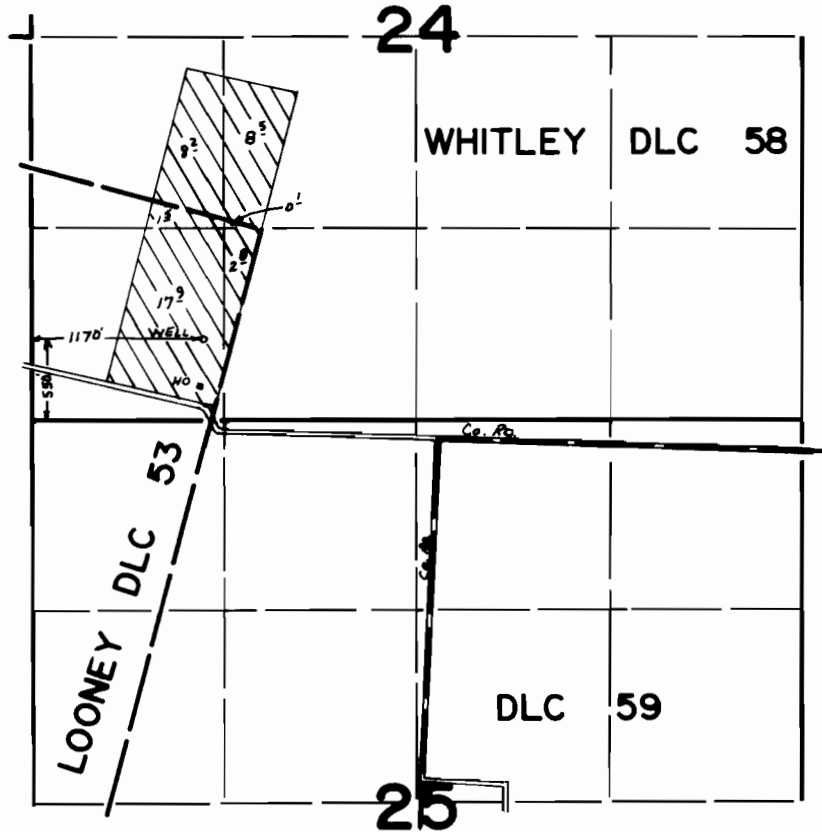

FINAL PROOF SURVEY
UNDER

Application No. G-6278. Permit No. G-5910.
IN NAME OF

..... LESTER D. GOODALL

Surveyed Oct. 8, 1976, by L. Toll