


T.9S.,R.2W.,W.M.

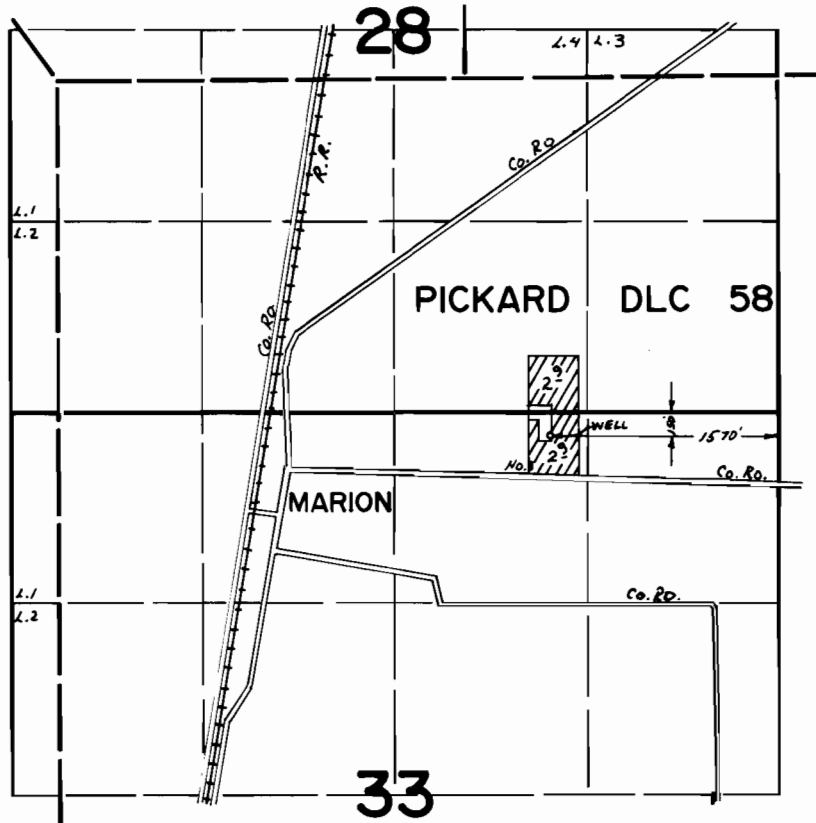

FINAL PROOF SURVEY
UNDER

Application No. G-6323. Permit No. G-5937.
IN NAME OF

KENNETH L. & CAROL J. HADLEY

Surveyed July 6, 1976, by L. Tolle