


T.6S.,R.2W.,W.M.

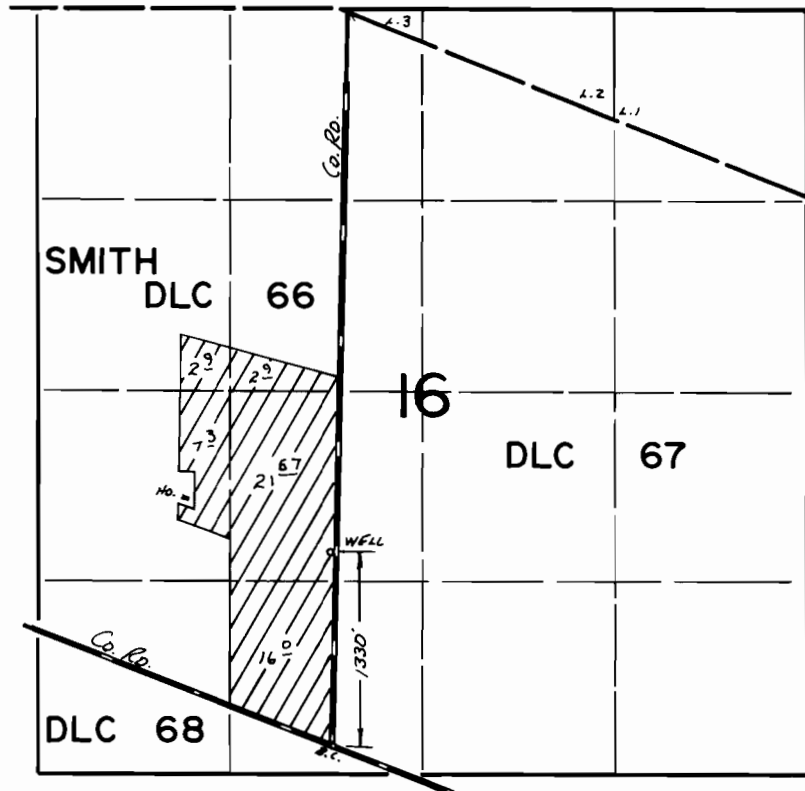

FINAL PROOF SURVEY
UNDER

Application No. G-6505 Permit No. G-6119...
IN NAME OF

MARLIN MIKKELSON

Surveyed MAY 21 1976, by L. TOLL