


# T. 9S., R. 3E., W.M.

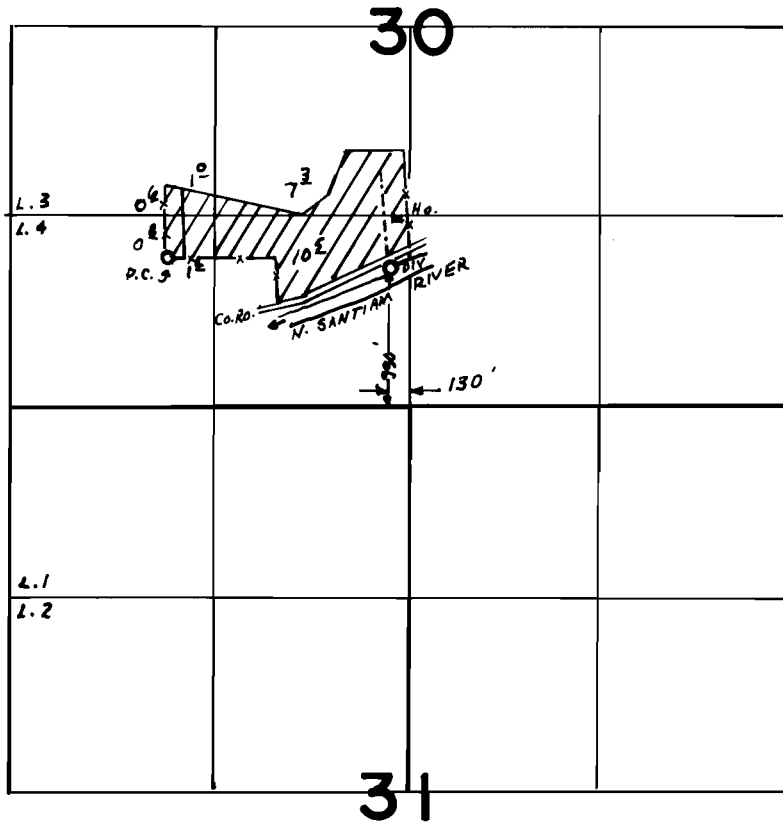

## FINAL PROOF SURVEY UNDER

Application No. 49613... Permit No. 37221...  
IN NAME OF

**JESSIE SAVAGE**

Surveyed SEPT. 9, 1976, by L. TOLL