


T.9S.,R.2E.,W.M.

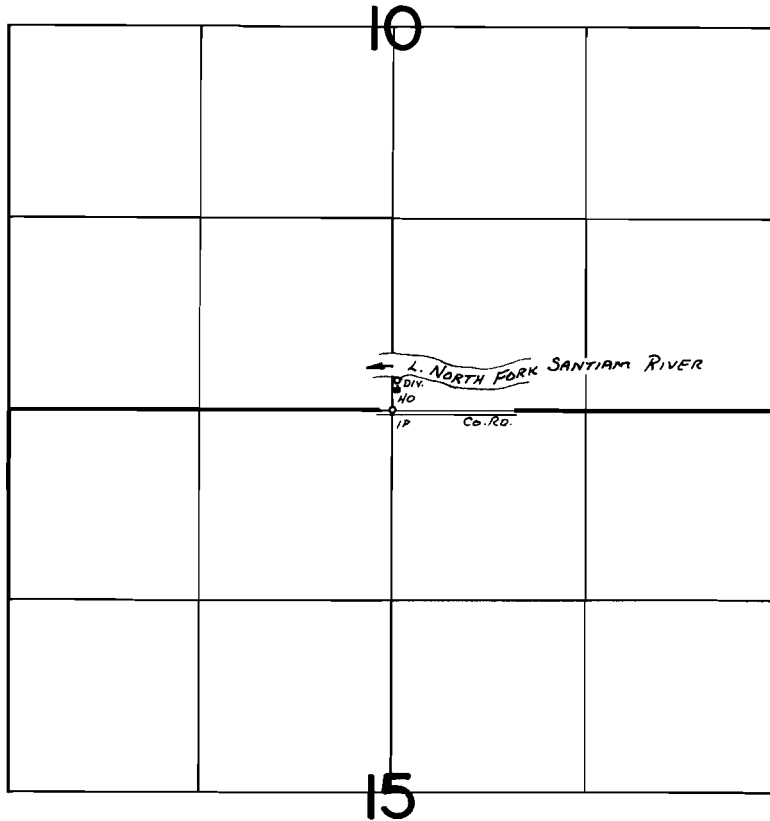

Div. Loc: 200' N AND 40' E FROM 5/4 COR SEC 10

**FINAL PROOF SURVEY**  
UNDER

Application No. 50335 Permit No. 38000  
IN NAME OF

Richard A. & Roberta F. Nichols

Surveyed SEPT. 8 1976, by L. TOLL