


T.9S.,R.2E.,W.M.

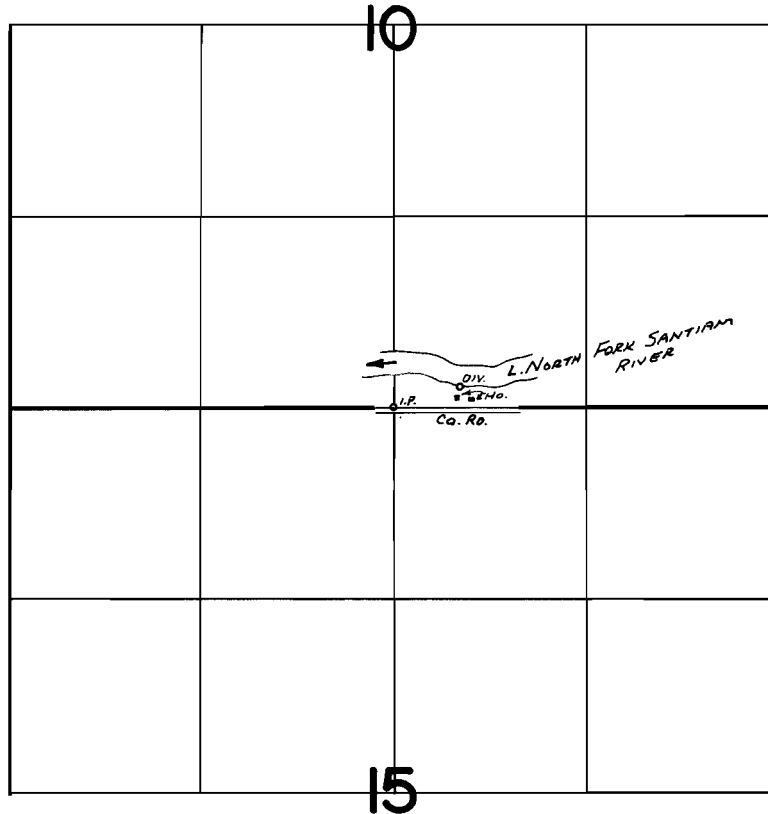

Div. Loc: 150' N AND 450' E FROM S¹/₄ COR SEC 10

FINAL PROOF SURVEY
UNDER

Application No. 50465 Permit No. 37845
IN NAME OF

MALCOLM & ERMA V. MACDONALD

Surveyed SEPT. 8 1976, by L. Toll