


T.6S.,R.2W.,W.M.

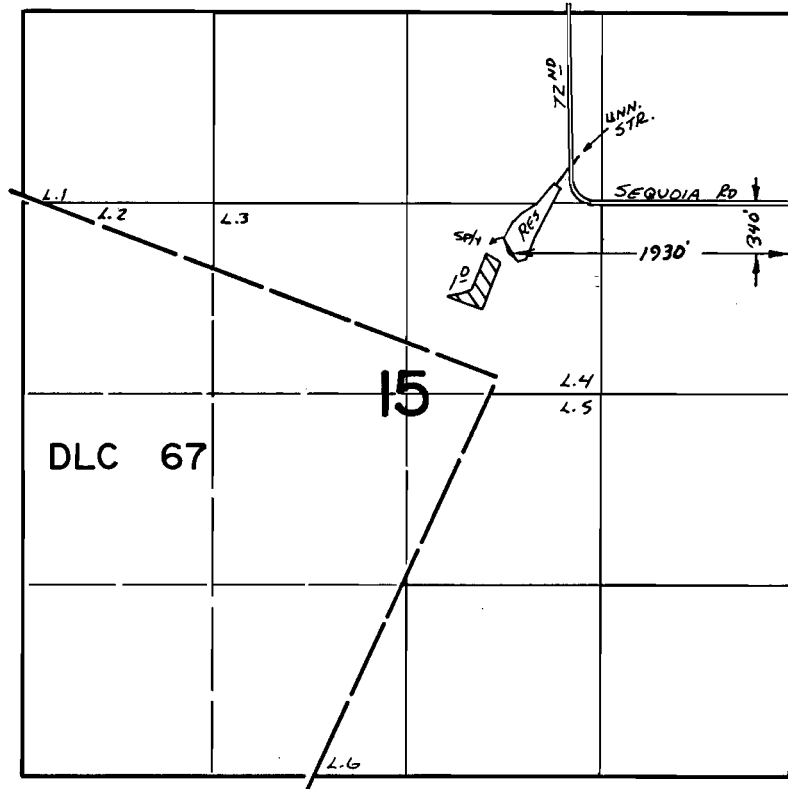

FINAL PROOF SURVEY UNDER

Application No. R-51897 Permit No. R-6075
51898 37404
IN NAME OF

FRANK HENNY, JR.

Surveyed MAY 17 1976, by L. TOLL