


RECEIVED

JUN 11 1974

STATE ENGINEER
SALEM, OREGON

T.4S. R.2W. W.M.

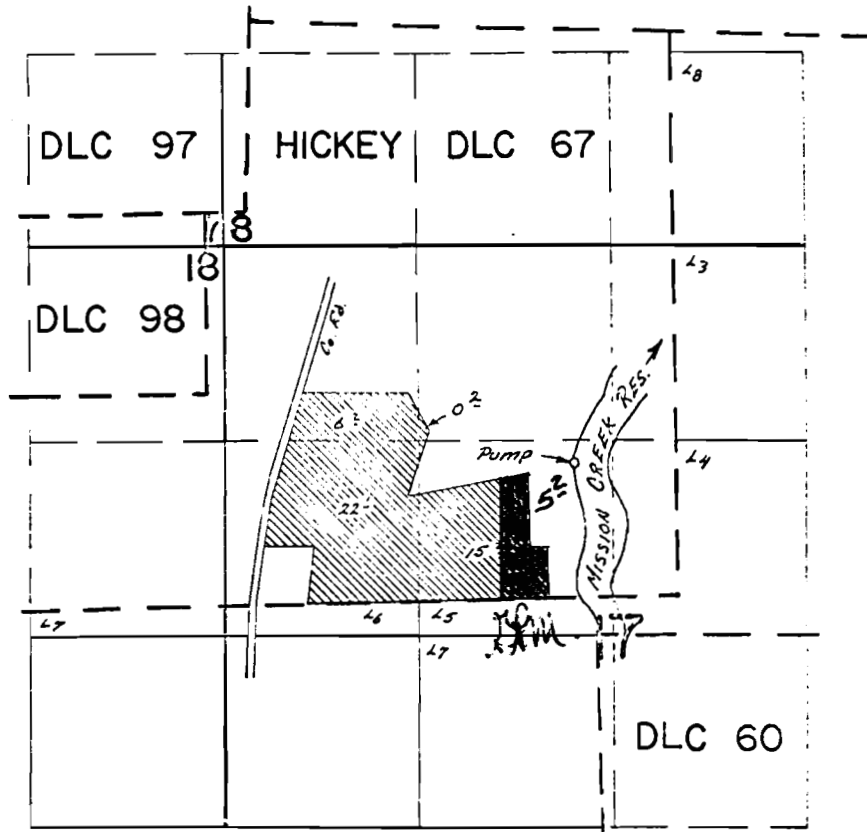

PUMP LOC: 890' N & 690' W FROM SE COR HICKEY DLC 67

FINAL PROOF SURVEY
UNDER

Application No. 45259 Permit No. 33221
IN NAME OF

MRS. TRESSIE MULLEN

Surveyed May 24 1973, by T.J. POUL

Application No. 52649
Permit No. 39226