


# T.1S. R.3E. W.M..

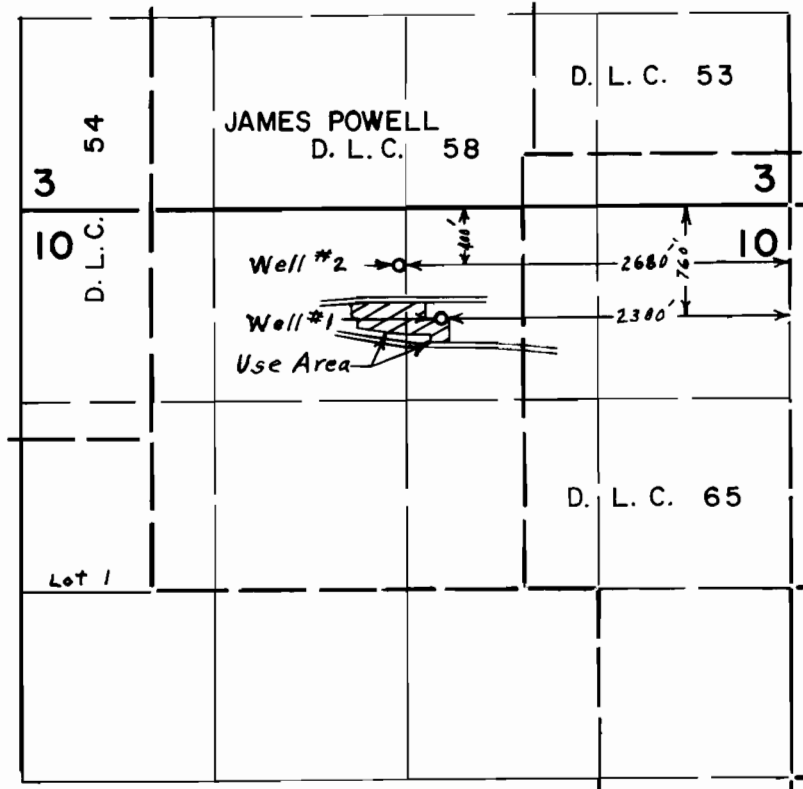

## FINAL PROOF SURVEY UNDER

Application No. G-6459 Permit No. G-6027  
IN NAME OF

*David Mitchell Cox*

Surveyed Aug. 9, 1976, by L. E. Gould