


T.6S. R.7W. W.M.

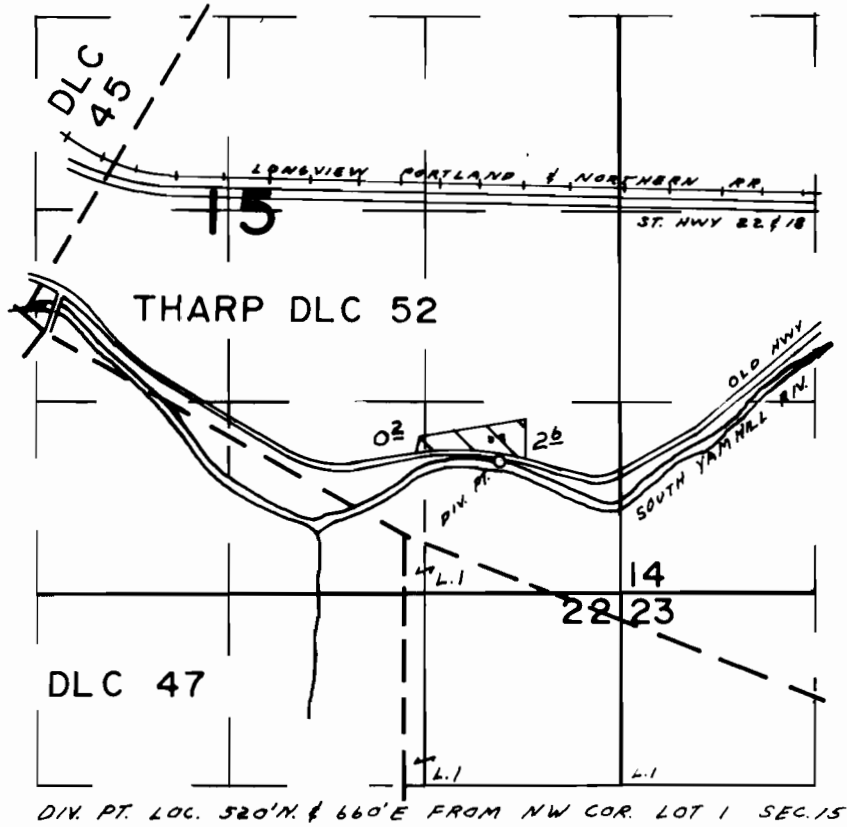

FINAL PROOF SURVEY
UNDER

Application No. 47175... Permit No. 35316...
IN NAME OF

Rudy & Gladys Soders

Surveyed JUL. 3... 1975, by L.H. NUNN.....