


T.6S. R.7W. W.M.

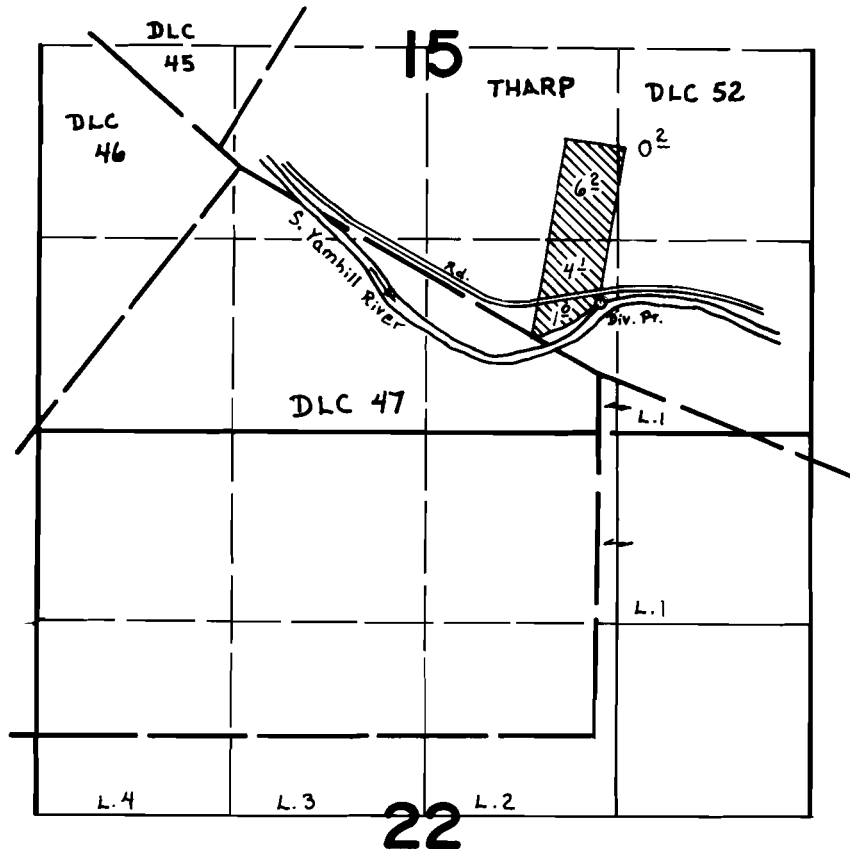

Div Pt Located: 900' N & 1450' W from SE cor Sec. 15

FINAL PROOF SURVEY UNDER

Application No. 54018 Permit No. 40473
IN NAME OF

WILLIAM JOLLEY

Surveyed SEPT. 15, 1977, by D. NORBY