


G-5411
46382

T.6N., R.35E., W.M.

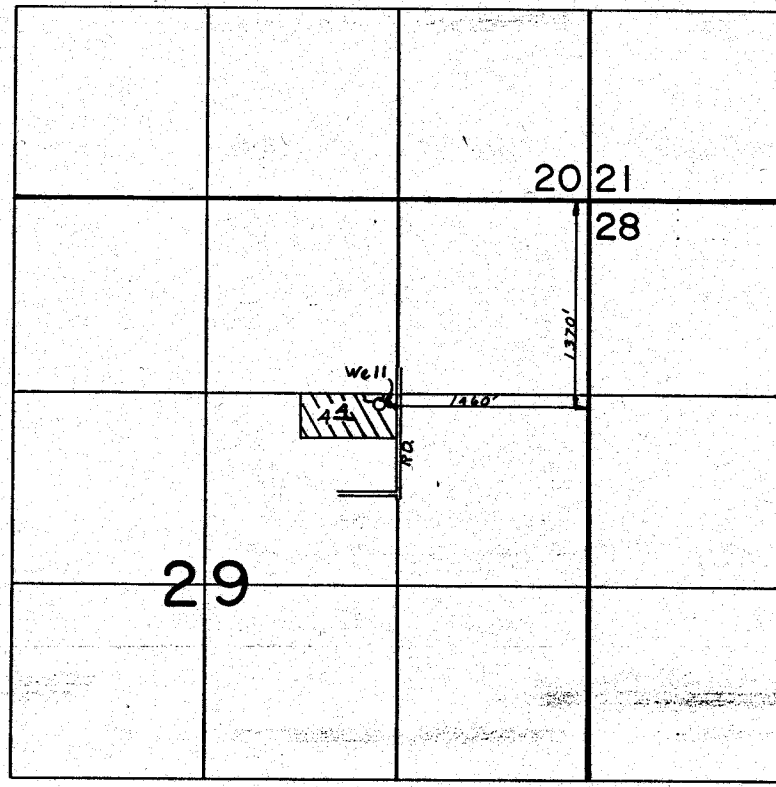

FINAL PROOF SURVEY
UNDER

Application No. G-5525 Permit No. G-5411
IN NAME OF
WILLIAM E. DIAL, JR.
Surveyed APR 9 1976, by C.R. KING