

T. 586 N. R. 348 35E. W.M.

FINAL PROOF SURVEY

UNDER

Application No. 33492 Permit No. 26499



IN NAME OF

HUDSON BAY DISTRICT IMPROVEMENT CO.

Surveyed Jan. 8-12, 1968, by J. HEINES
April 18 73 R. G. MUCKLEY

PHOTOS NZ-TEE-77, BEF-102, 106, 2EE-29
NZ-5MM-69, 71, 73

PRIMARY  SUPPLEMENTAL 

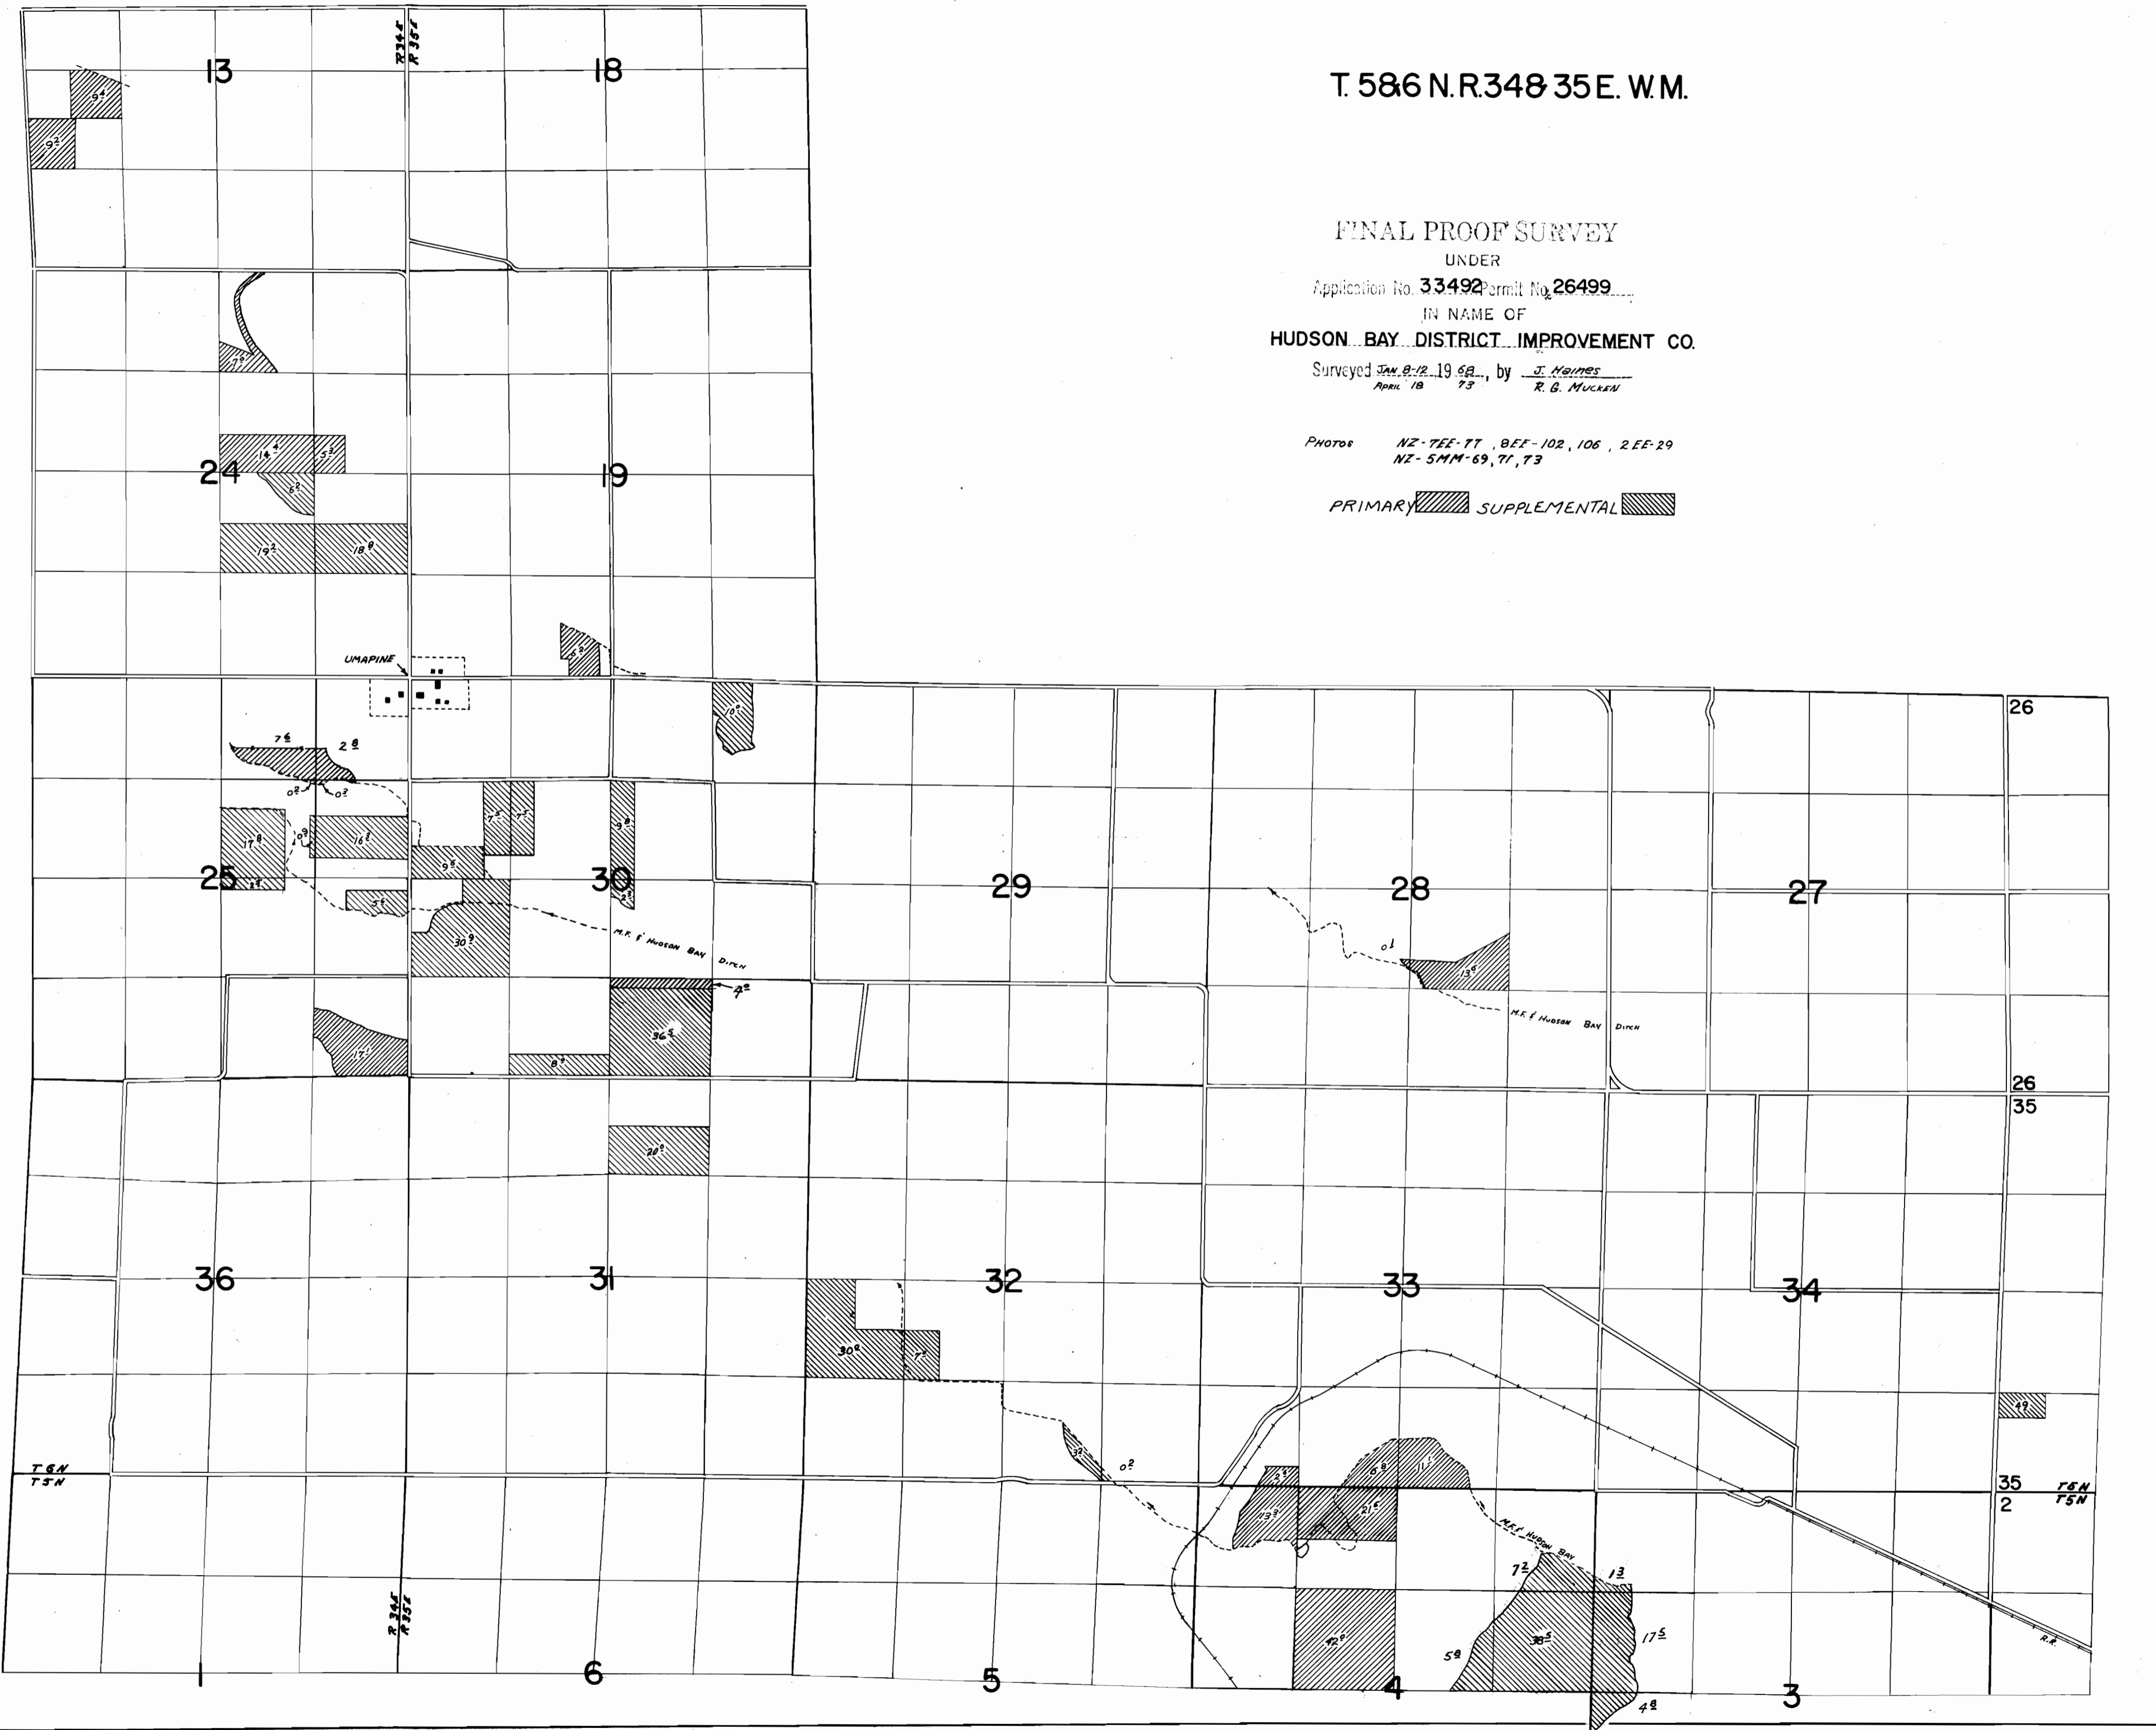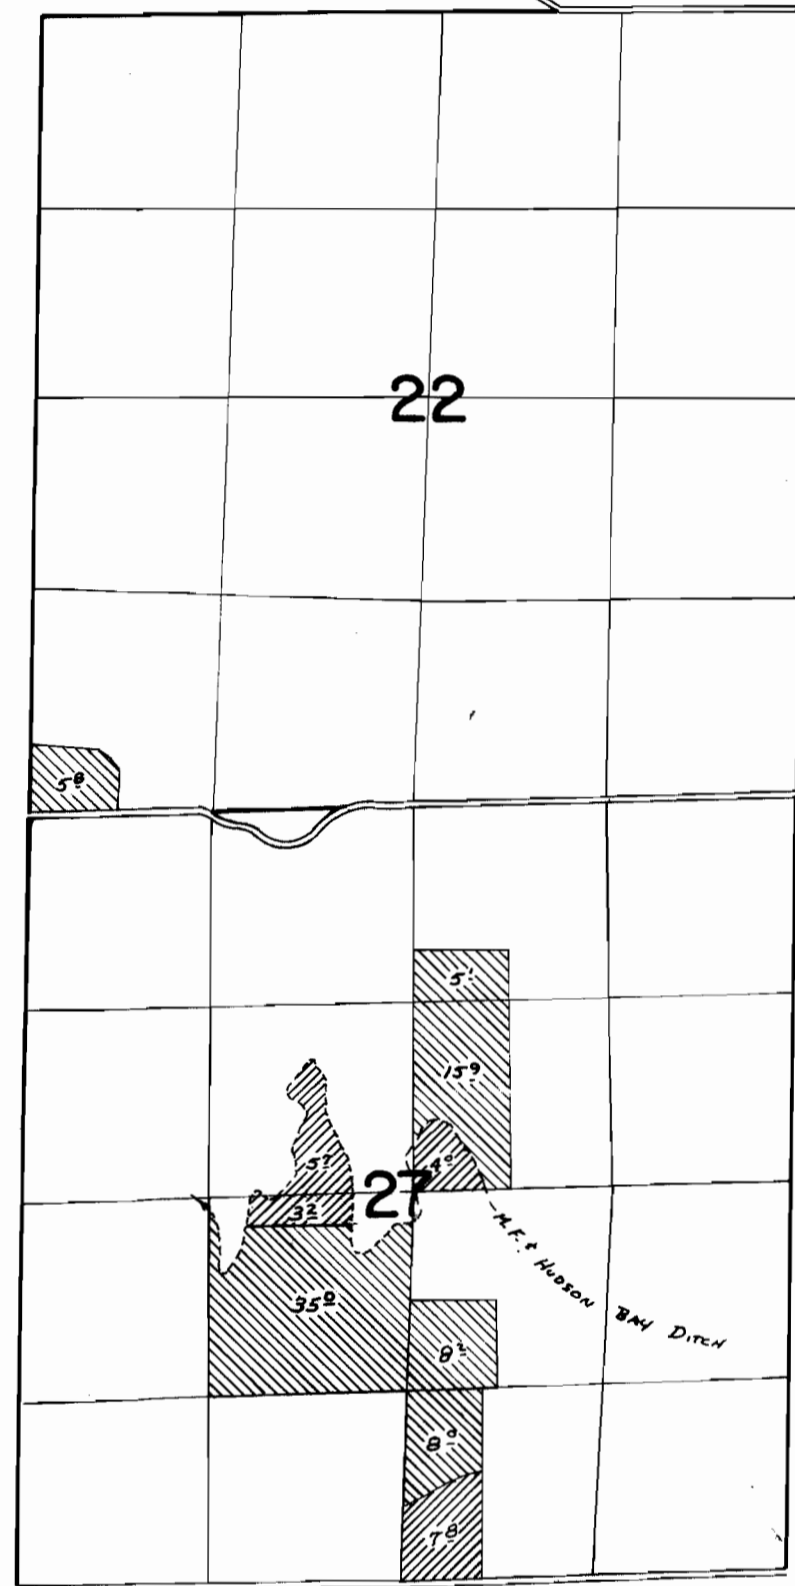

T. 5N. R. 35E W.M.

