


T. 1 N., R. 34 E., W.M.

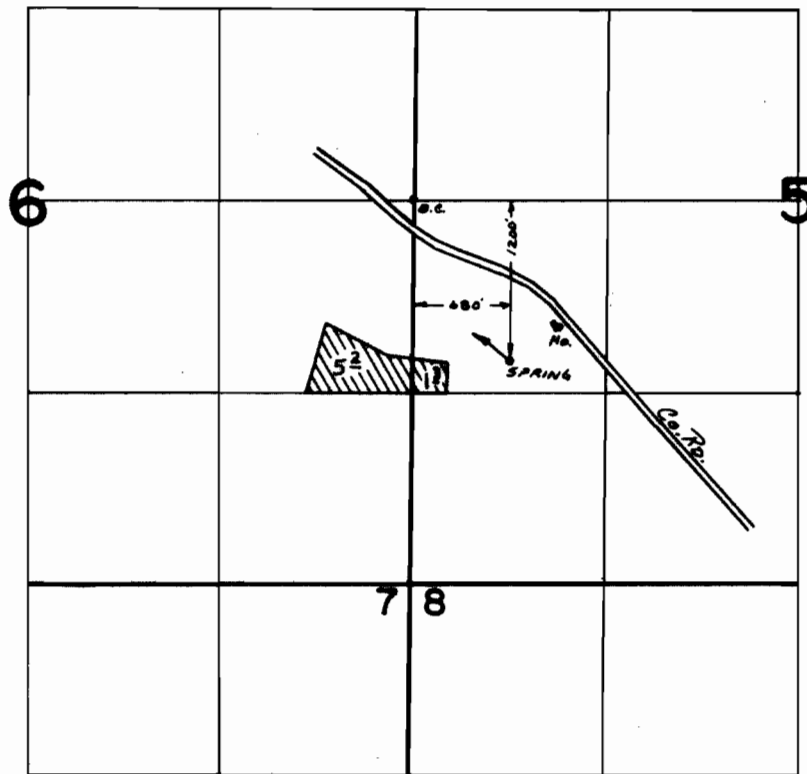

FINAL PROOF SURVEY UNDER

Application No. 46700 Permit No. 34897
IN NAME OF

MELVIN WILSON

Surveyed Area 2 1975, by L. Toll