


T.2N. R.30E. W.M.

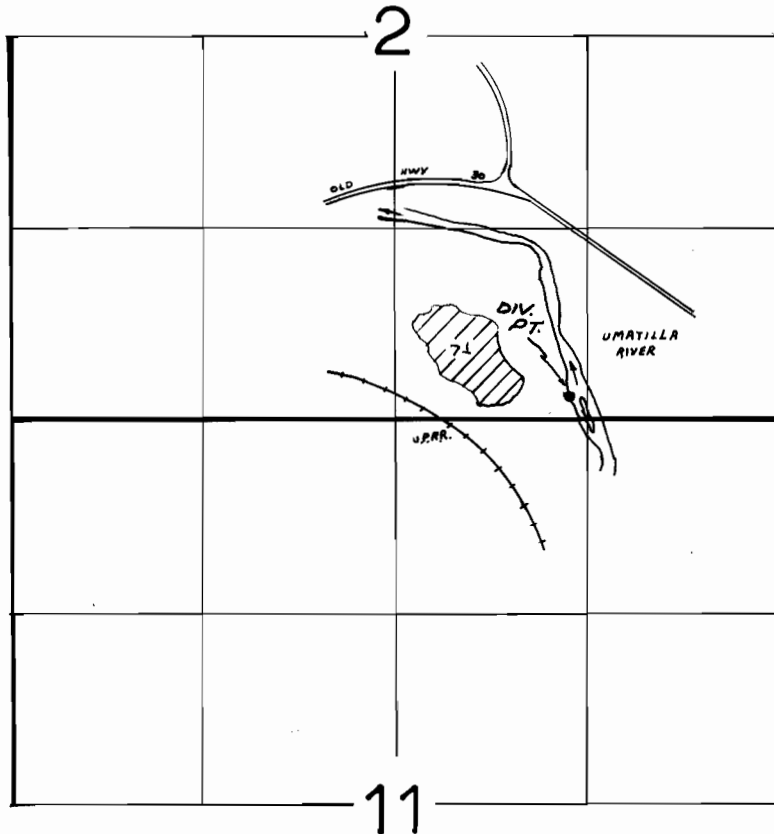

POD LOCATED 150'N & 1450'W FROM SE COR SEC 2

**FINAL PROOF SURVEY**  
UNDER

Application No. 54049 Permit No. 40423  
IN NAME OF

LEWIS LIVESTOCK INC.

Surveyed Feb. 17, 1978, by R. Berwin