


T.1&2S., R.39E., W.M.

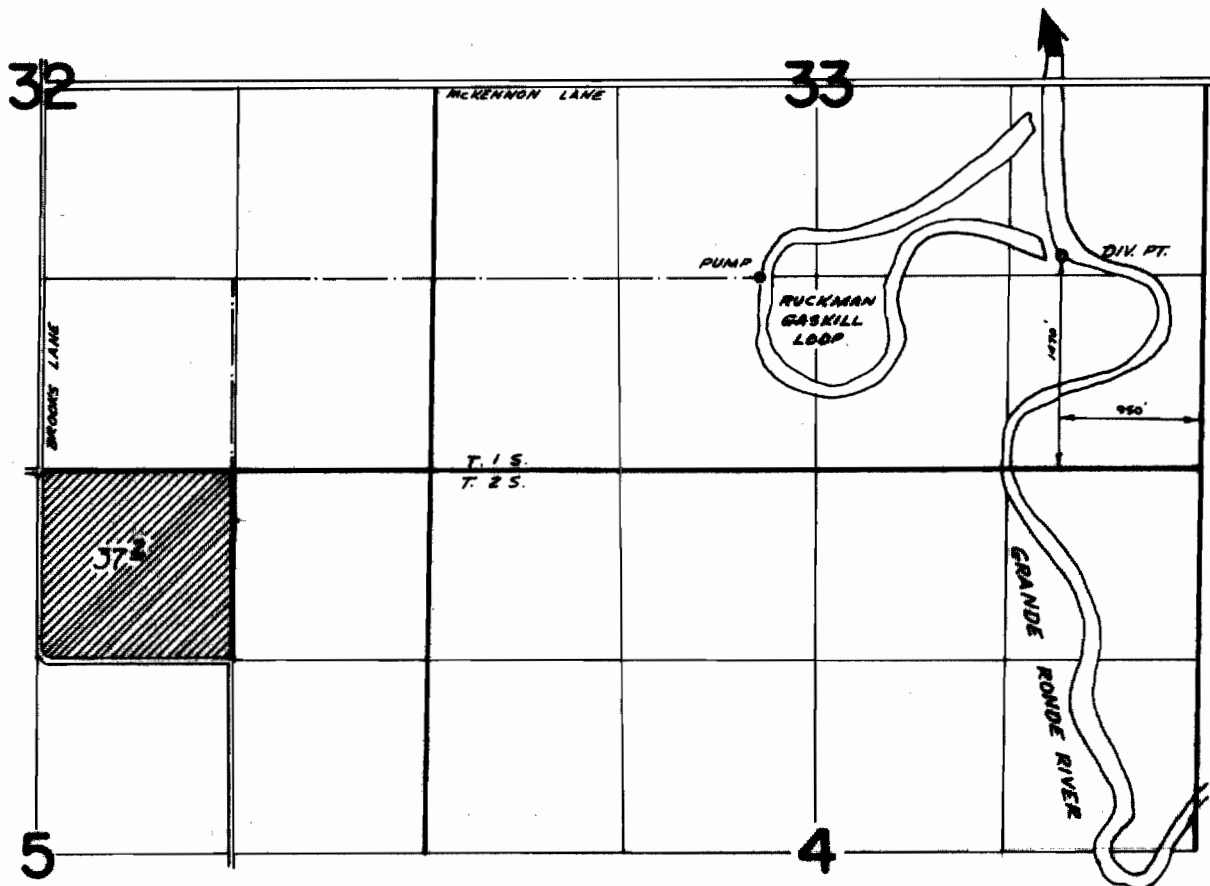

FINAL PROOF SURVEY
UNDER

Application No. 47182 Permit No. 35348
IN NAME OF

WILLIAM B. & SHERRIL R. TEETER

Surveyed April 4 1975, by D. Norby