


P-32023

46371

T.1S.,R.24E.,W.M.

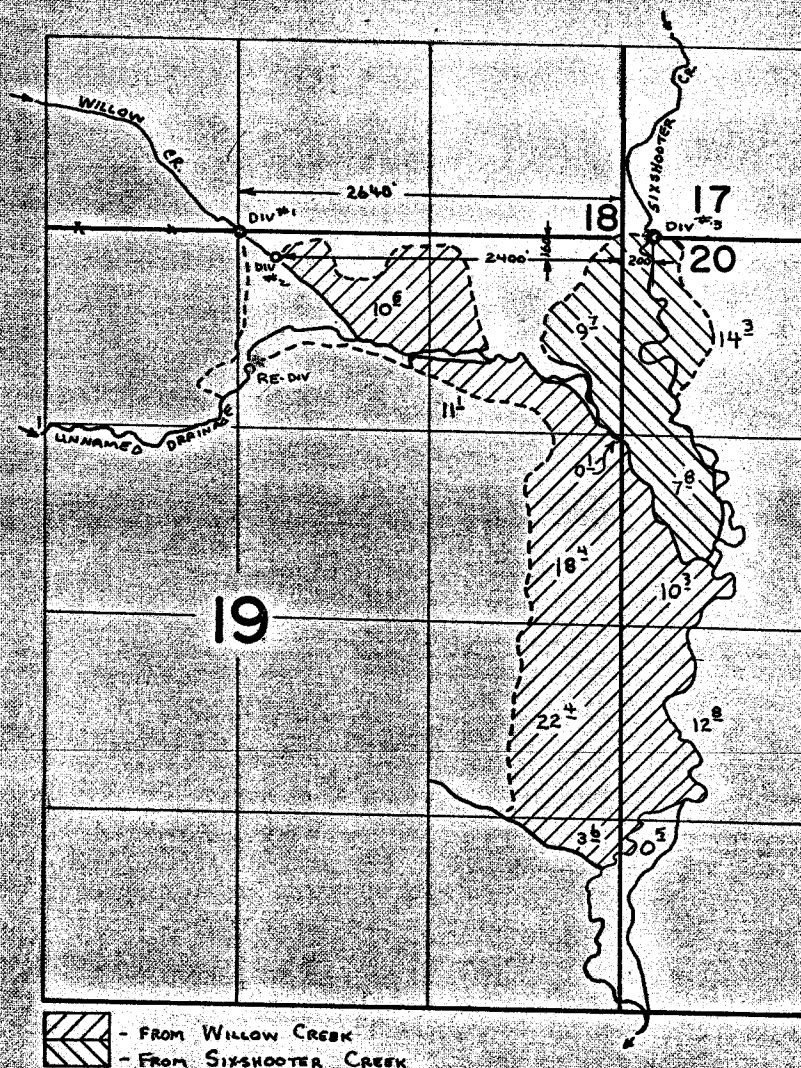

FINAL PROOF SURVEY UNDER

Application No. 42844 Permit No. 32023
IN NAME OF

ELMER J. JACKSON

Surveyed JUNE 12 1975, by L. Toss