



# T.13S., R.5W., W.M.

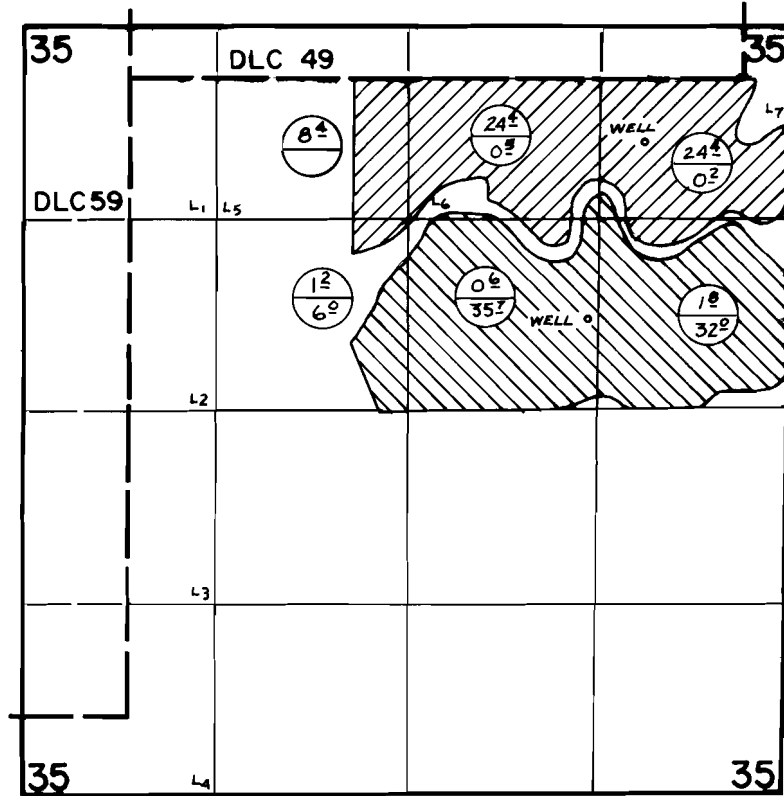

WELLS LOC: NORTH WELL- 420' S & 3530' E; SOUTH WELL- 1610' S & 3130' E BOTH FROM NW COR LOT 1.

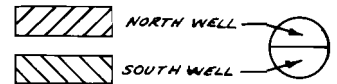

## FINAL PROOF SURVEY UNDER

Application No. G-5244 Permit No. G-5099  
IN NAME OF

DAN TRACER

Surveyed May 17 1976, by D. Norby