T. 22 S. R. 7 W. W.M.

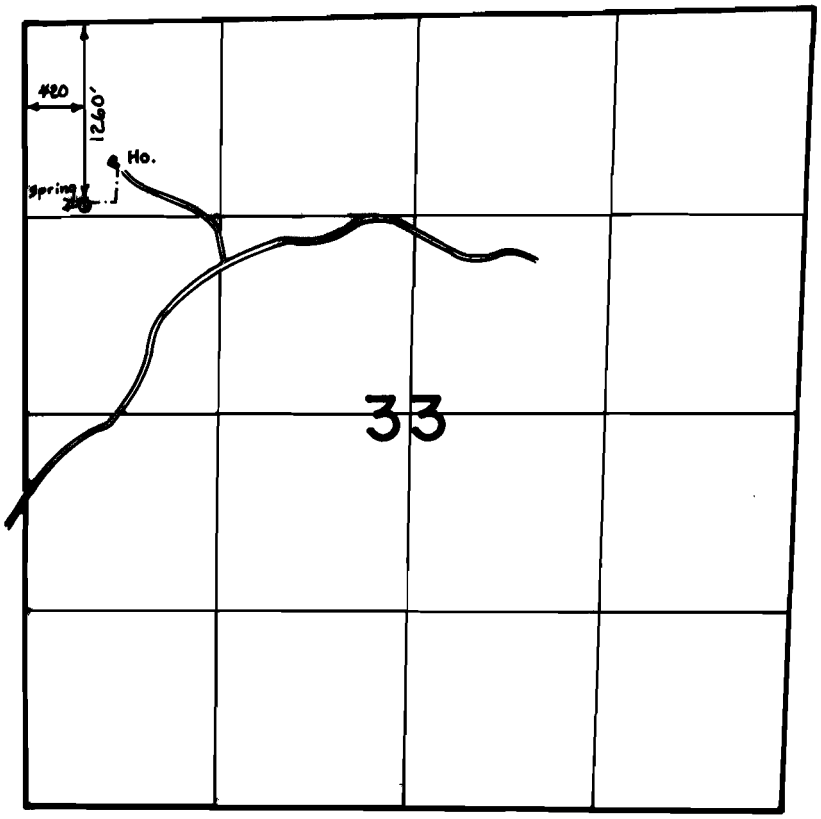

SCALE: 4" = 1 mile

FINAL PROOF SURVEY
UNDER

Application No. 53654 Permit No. 40121
IN NAME OF

DAVID E. SELBY

Surveyed Aug. 22, 1979, by S. Donaldson

22s 7w SW photo