


T.26S. R.6W. W.M.

SEC. 15

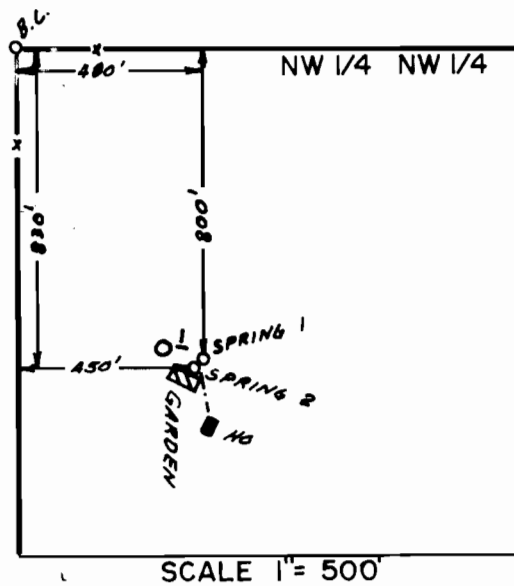

FINAL PROOF SURVEY
UNDER

Application No. 45891..... Permit No. 34266.....
IN NAME OF

ESTATE OF JOHN L. McCULLOUGH.....

Surveyed SEP. 14. 1976, by L.H. NUNN.....