


T.28S., R.7W., W. M.

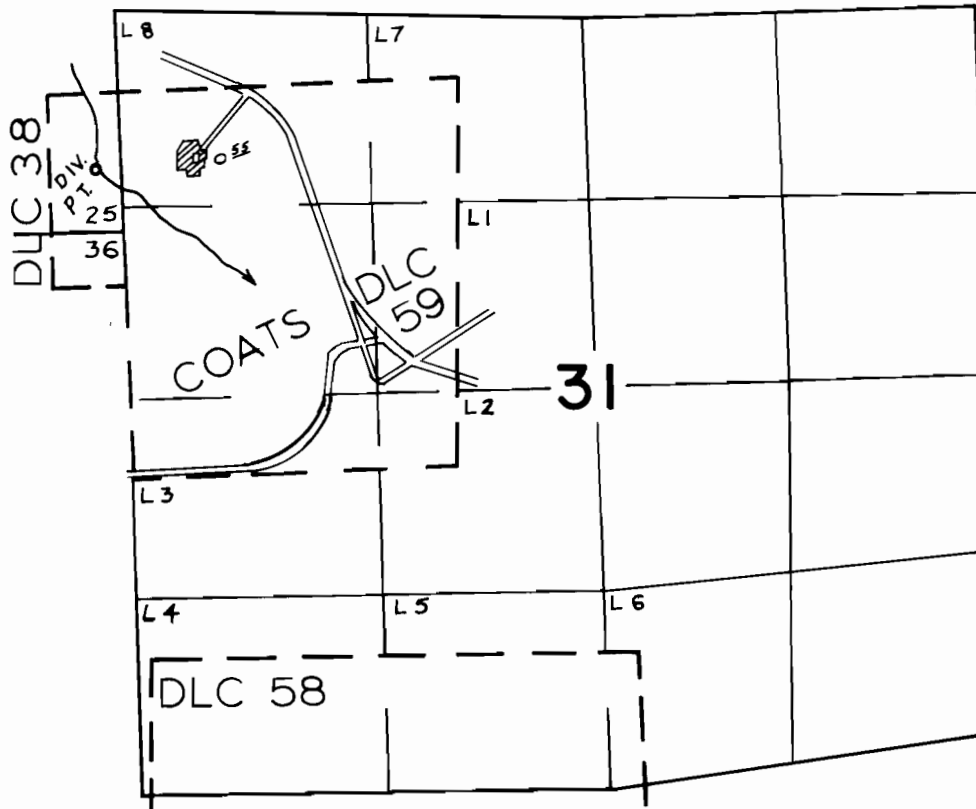

FINAL PROOF SURVEY
UNDER

Application No. 48642 Permit No. 36486
IN NAME OF

VIRGIL C. VANCE

Surveyed JULY 5 1977, by F.P. COGGSWELL