


# T.26S. R.6W. W.M.

1" = 500'

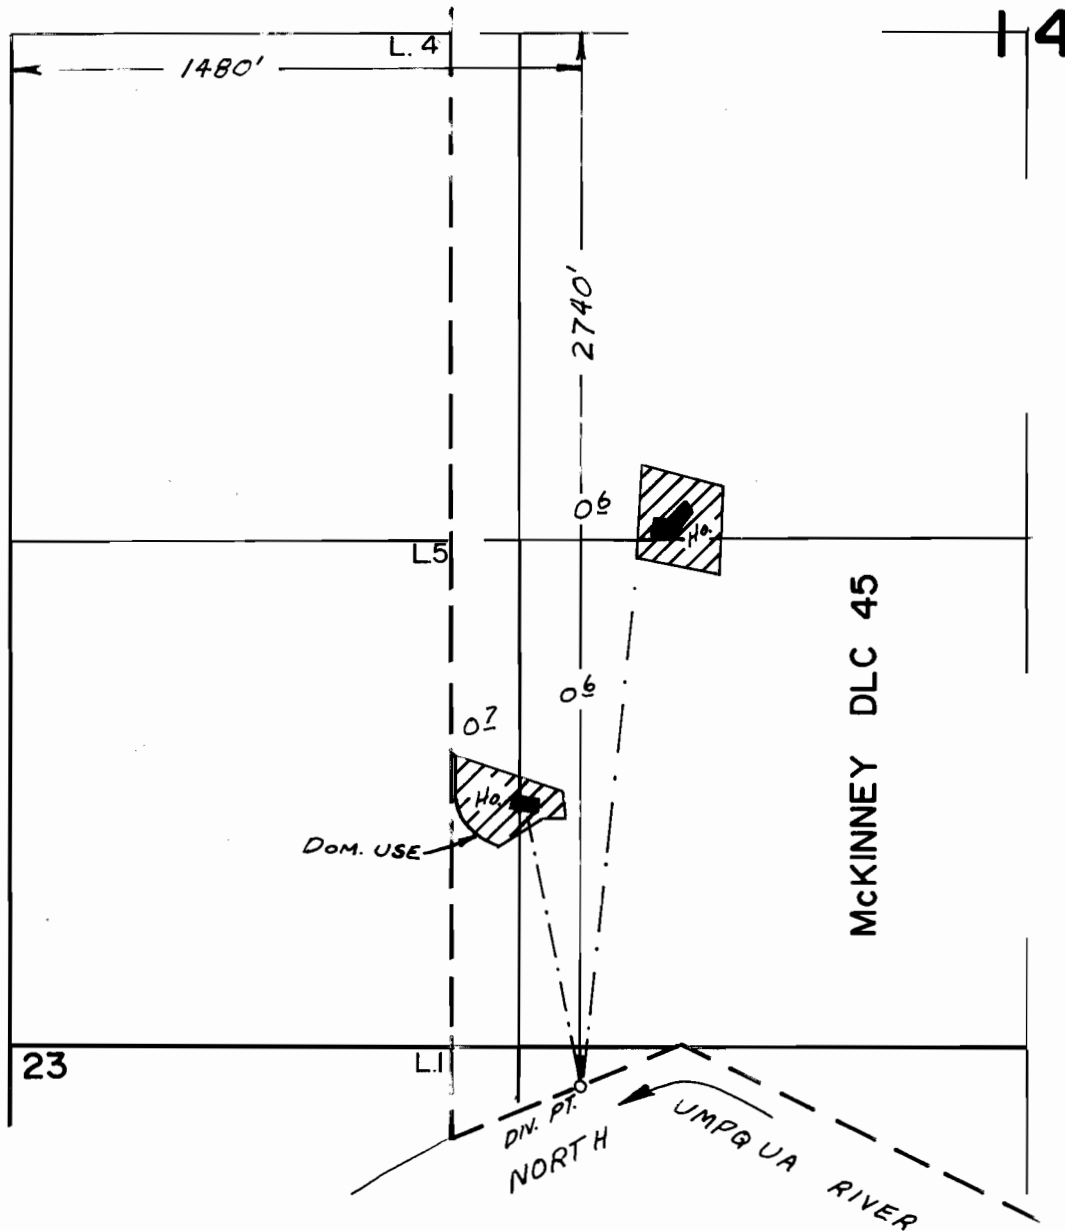

## FINAL PROOF SURVEY UNDER

Application No. 50260... Permit No. 37915...  
IN NAME OF

RICHARD H. HARRELL

Surveyed SEP. 14. 1976., by L.H. NUNN