


T.25S., R.5W., W.M.

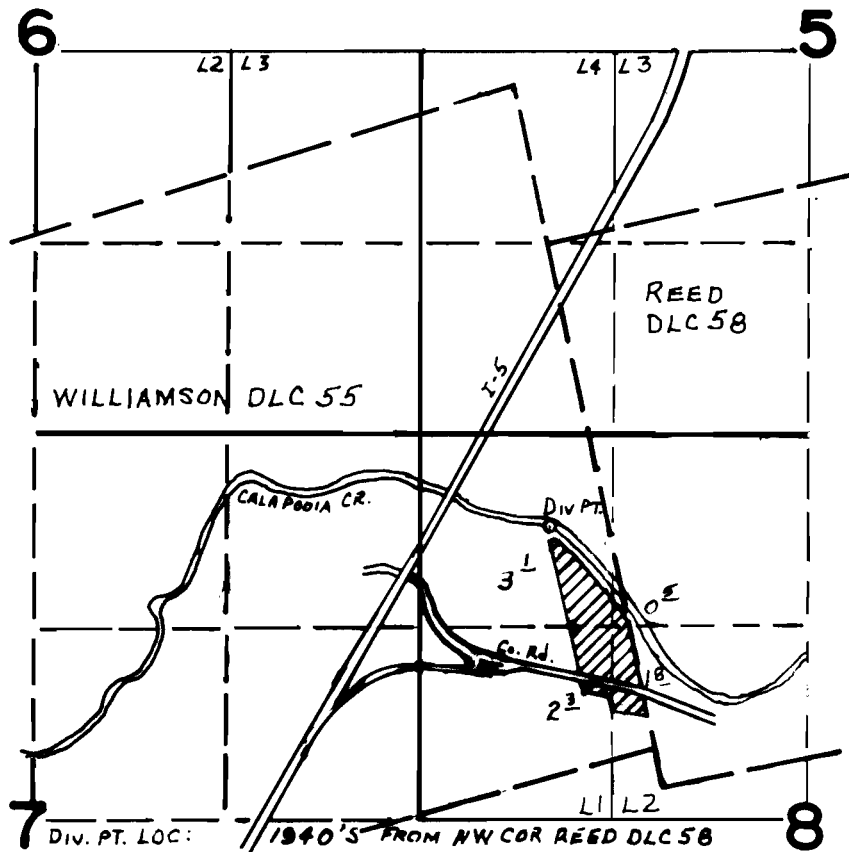

FINAL PROOF SURVEY UNDER

Application No. 50536 Permit No. 38158
IN NAME OF

DELBERT P. SPENCER

Surveyed July 29 1976, by D. NORBY