


P 34366
96386

T.13S. R.31E. W.M.

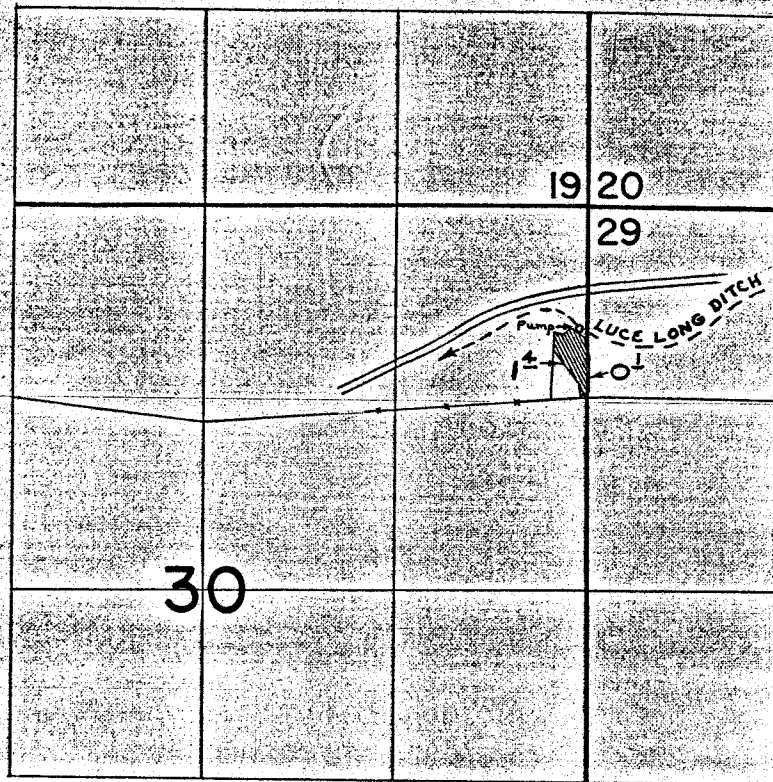

DIV. PT. FROM JOHN DAY RIVER LOC: 1000' N. & 10' E. FROM S. 1/4 COR. SECTION 22
SHOWN ON F.R. MAP APP. 36120

FINAL PROOF SURVEY UNDER

Application No. 46012 Permit No. 34366
IN NAME OF

C-H 4386

Dale L. & Thelma Robinson

Surveyed JUNE 26, 1975, by R. MUCKEN