


T.23S., R.31E., W.M.

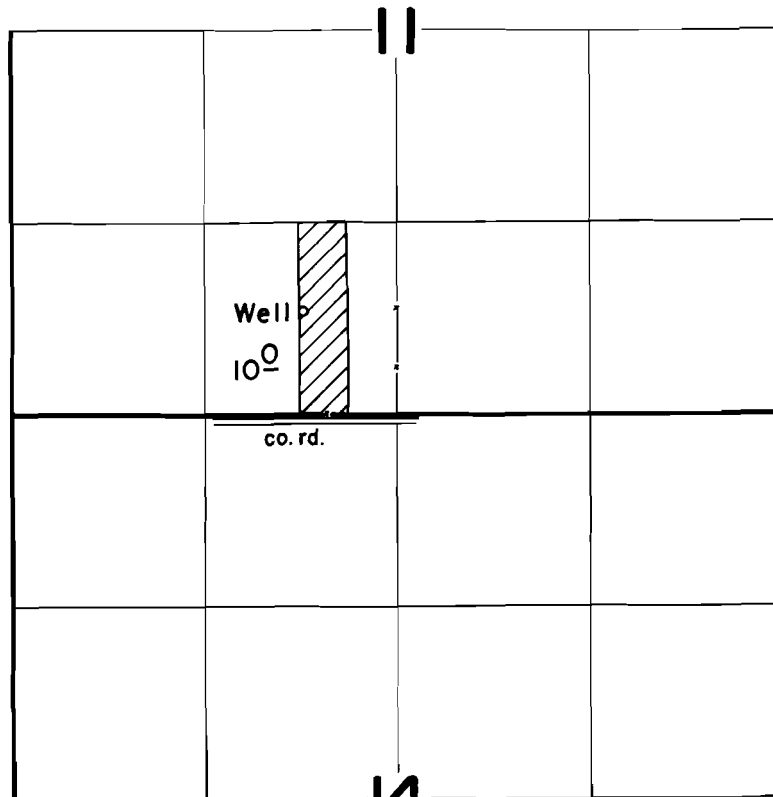

WELL LOC: 710' N & 640' W FROM S 1/4 COR. SEC. 11

**FINAL PROOF SURVEY**  
UNDER

Application No. G-5365 Permit No. G-5300  
IN NAME OF

JERRID DELL MERRILL

Surveyed April 29 1976, by D. Norby