


**T.26 & 27S., R.33E., W.M.**

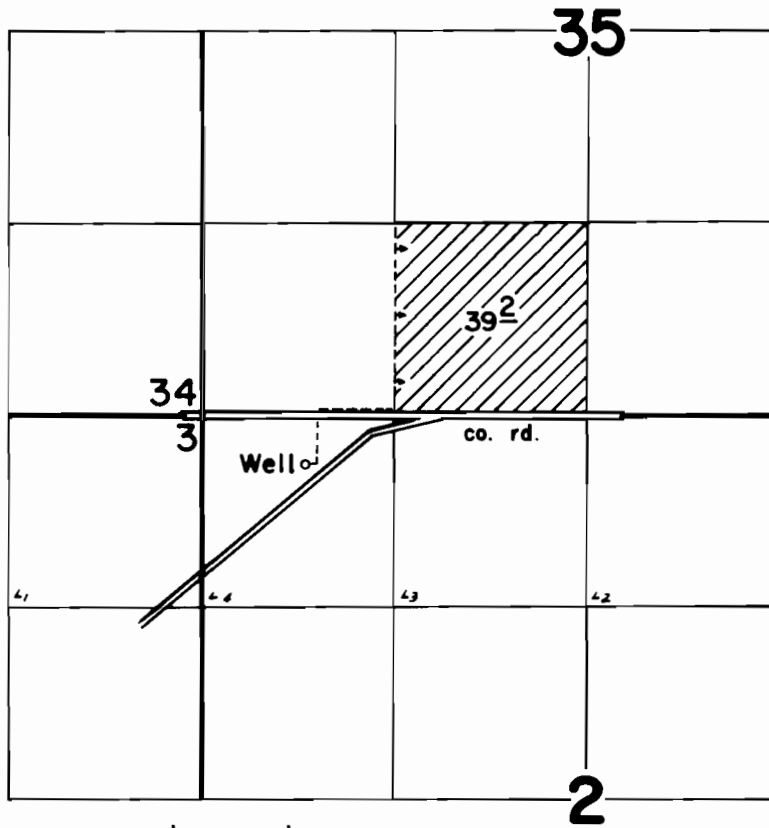

Well Loc: 330' S & 700' E from NW cor. section 2

**FINAL PROOF SURVEY**  
UNDER

Application No. G-5516 Permit No. G-4914  
IN NAME OF

*Herbert C. Davis*

Surveyed April 23 1976, by D. Norby