


T.23S., R.31E., W.M.

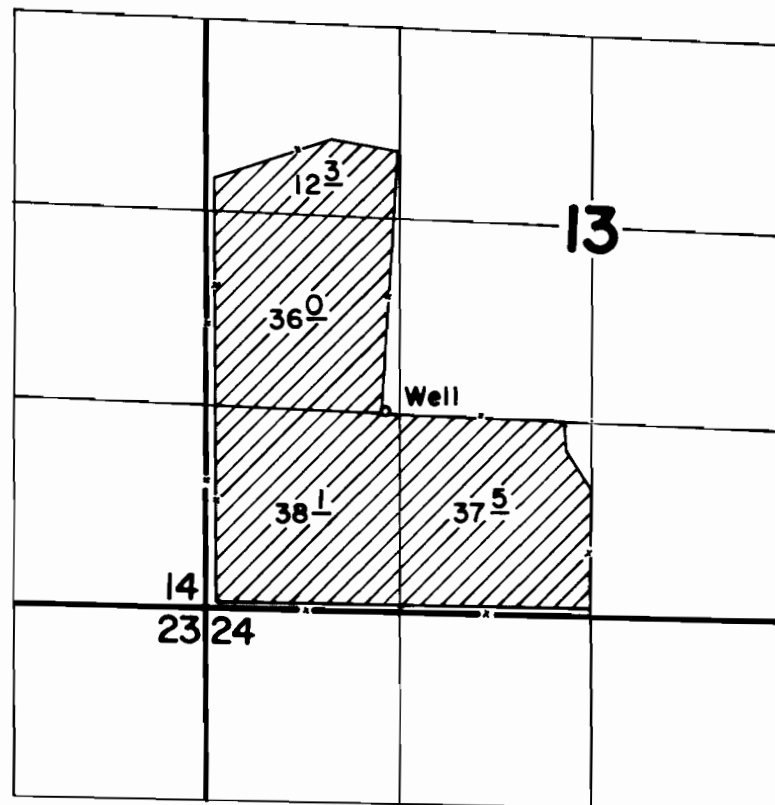

WELL LOC: 1380' N & 1230' E FROM SW COR. SEC. 13

FINAL PROOF SURVEY
UNDER

Application No. G-5872 Permit No. G-5603
IN NAME OF

CLARENCE GARDNER

Surveyed April 28 1976, by D. Norby