


T23S. R31E.W.M.

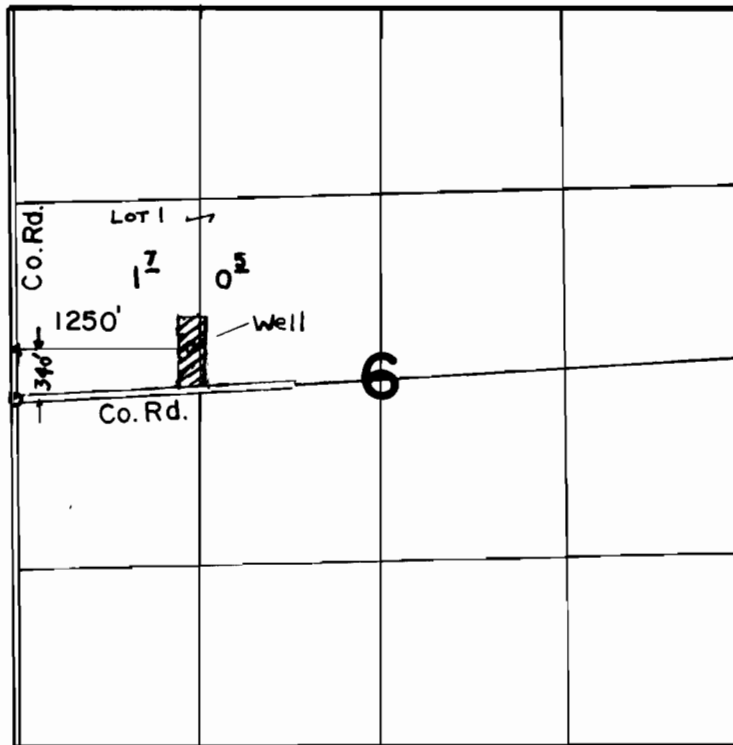

FINAL PROOF SURVEY
UNDER

Application No. G-6422 Permit No. G-5997
IN NAME OF

MARVEL G. GRAVEN

Surveyed April 21, 1976, by D. Norby