


~~R-5112~~

T.2N., R.10E., W.M.

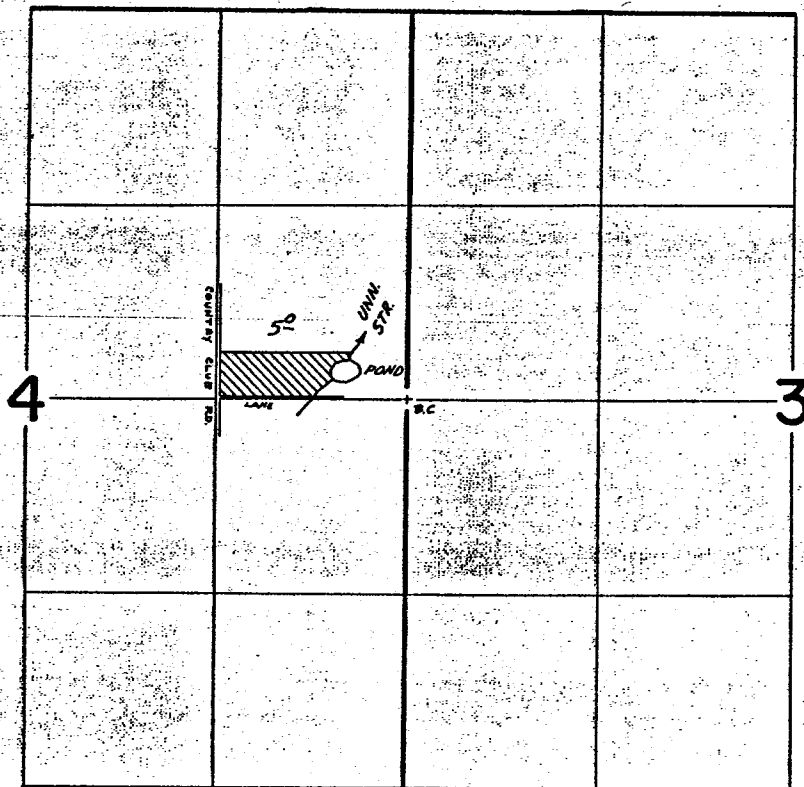

RES. LOC: 260' N & 400' W FROM E 1/4 CDR. SEC. 4

FINAL PROOF SURVEY UNDER

R-5112 R-6056
Application No. 5113 Permit No. 37324
IN NAME OF

FRANK S. BUEHLER

Surveyed April 14 1975, by D. Norby