


R-100  
~~R-5112~~

# T.2N., R.10E., W.M.

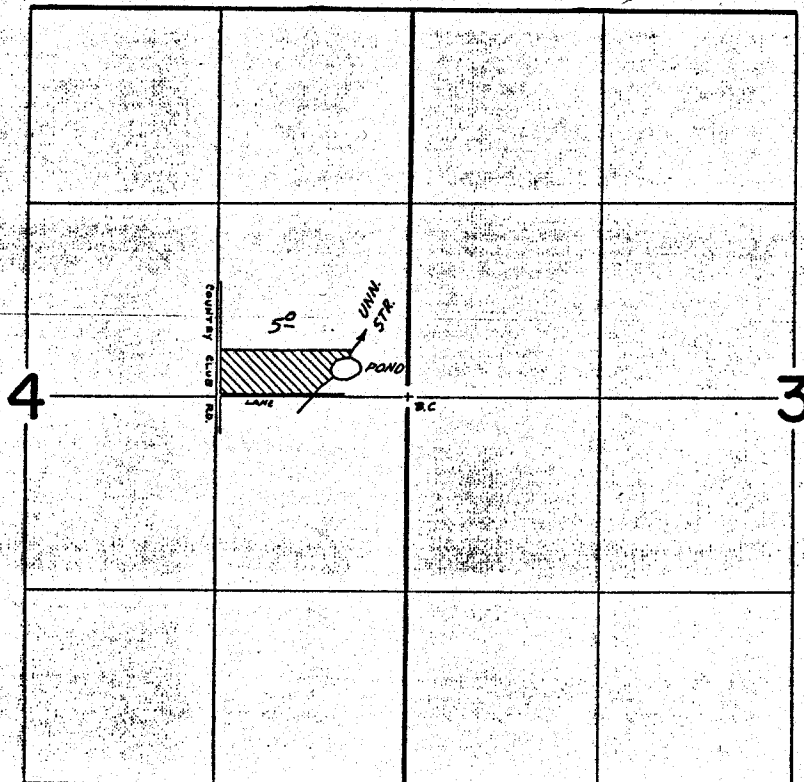

RES. LOC: 260' N & 400' W FROM E 1/4 COR. SEC. 4

## FINAL PROOF SURVEY UNDER

R-5112                      R-6056  
Application No. 5113      Permit No. 37324  
IN NAME OF  
FRANK S. BUEHLER

Surveyed April 14 1975, by D. Norby