


T.39S.,R.5W.,W.M.

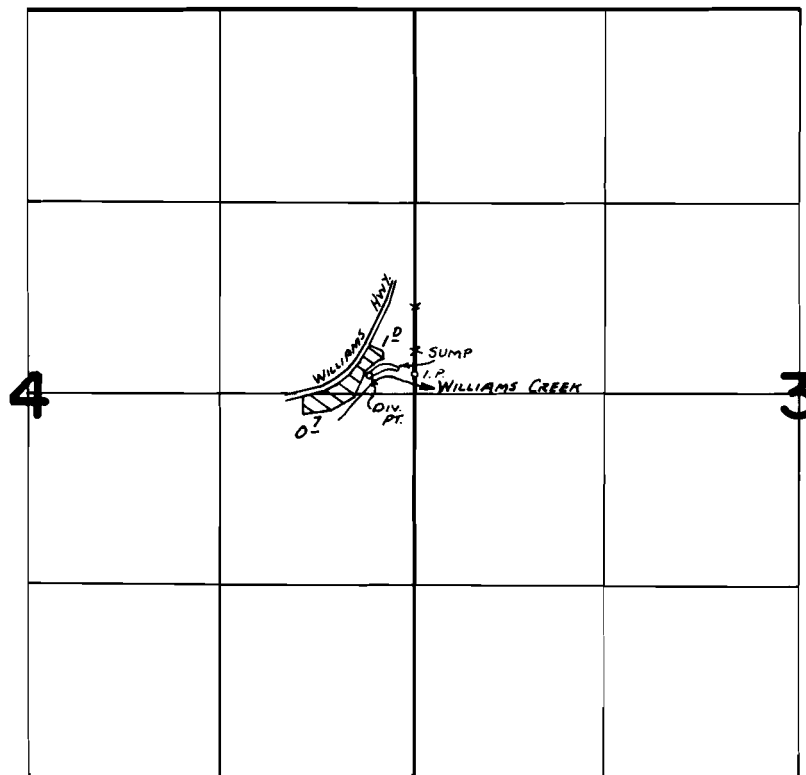

Div. Loc: 130' N AND 320' W FROM E 1/4 COR SEC 4

FINAL PROOF SURVEY

UNDER

Application No. G-5290 Permit No. G-5126
IN NAME OF _____

RICHARD W. LATHAN, SR.

Surveyed APRIL 29 1976, by L. TOLL.....