


T. 33 S. R. 6 W. W.M.

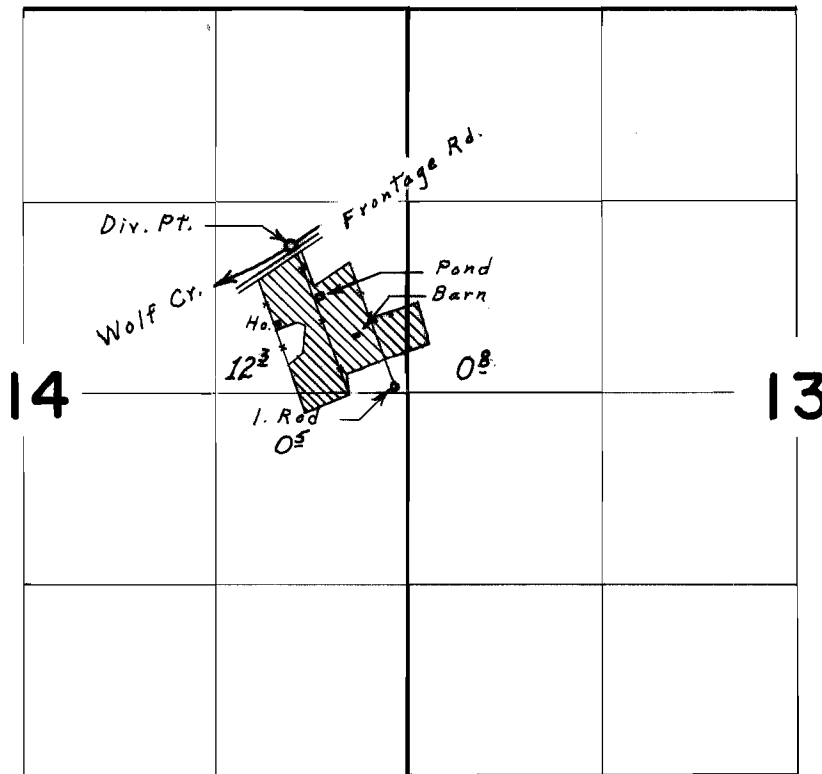

Div. Pt. located 1630' S. & 800' W. from N.E. Cor. Sec. 14

FINAL PROOF SURVEY
UNDER

Application No. 39924 Permit No. 29678
IN NAME OF

WILLIAM R. & SUSAN J. CUPPLES

April 26, 1974 L. E. Gould
Surveyed April 16, 1970, by R. G. Muehen
REVISED - MAY 10, 1977 L. M. TOLL

Hand-drawn map of a property with labels: Div. Pt., Wolf Cr., Frontage Rd., Pond, Barn, Ho., 12 1/2, I. Red, 0 1/2, 0 1/2. The map shows a shaded area with various points and lines.

1970-J & 1974-K