


T.39S.,R.8W.,W.M.

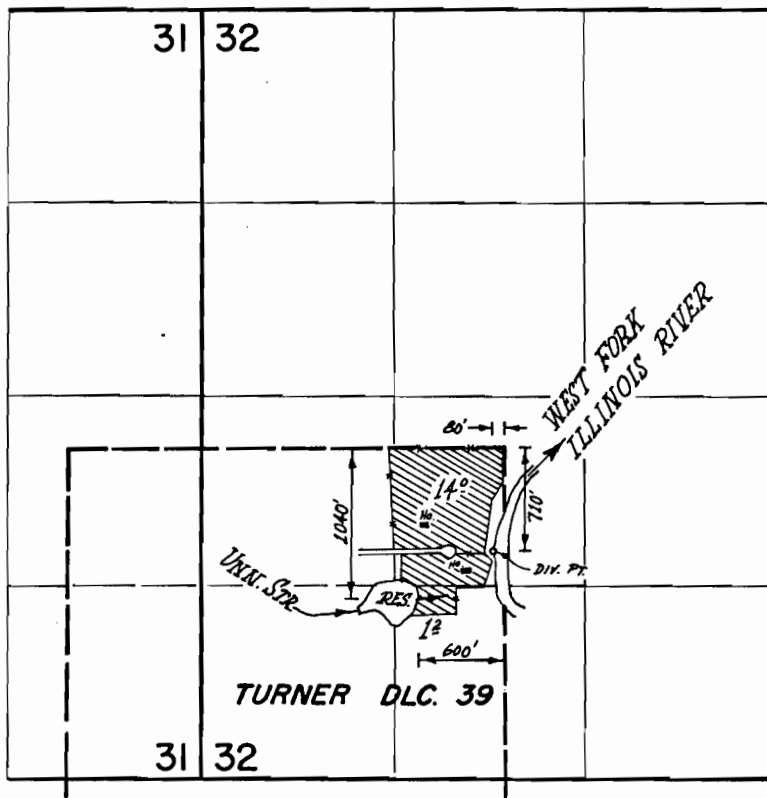

FINAL PROOF SURVEY
UNDER

R-44883 R-5301
Application No. 44884 Permit No. 33558
IN NAME OF

WM. H. HARTWIG & GEORGE T. DEDES

Surveyed JUNE 8 1917, by L.M. TOLL