


6-5082  
46408

T.39S., R.13E., W.M.

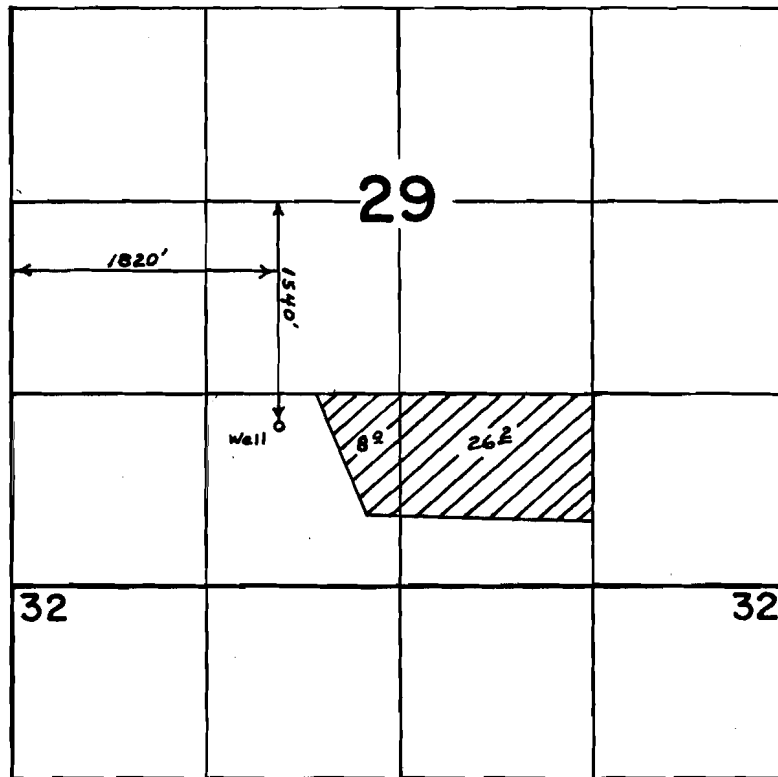

Muler cbr. wells

Basin....., Vol. ....

**FINAL PROOF SURVEY**  
UNDER

Application No. G-5223 Permit No. G-5082  
IN NAME OF

ELDON & VIRGINIA KENT

Surveyed JUNE 9, 1976, by D. NORBY

J.S.D.  
CNO-77K-78