


6-5422
46409.

T.37S., R.10E., W.M.

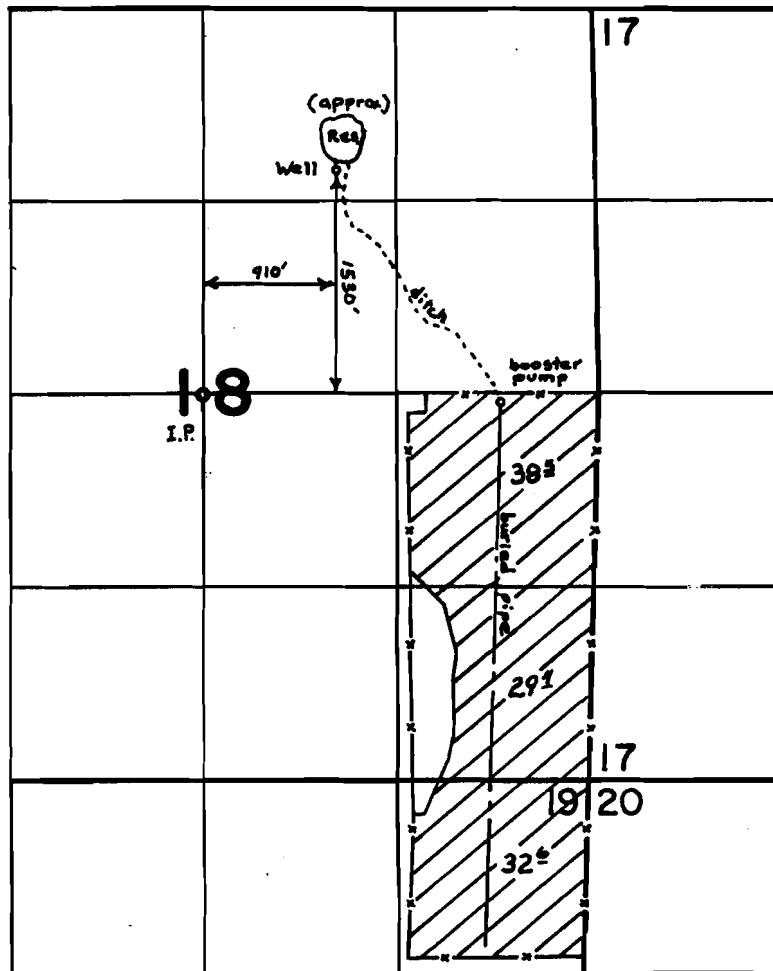

Swan Stake Wells

FINAL PROOF SURVEY UNDER

Application No. G-5538 Permit No. G-5422
IN NAME OF

PAUL T. GOLDEN

Surveyed JUNE 10 1976, by D. NORBY