


T.16S., R.4W., W.M.

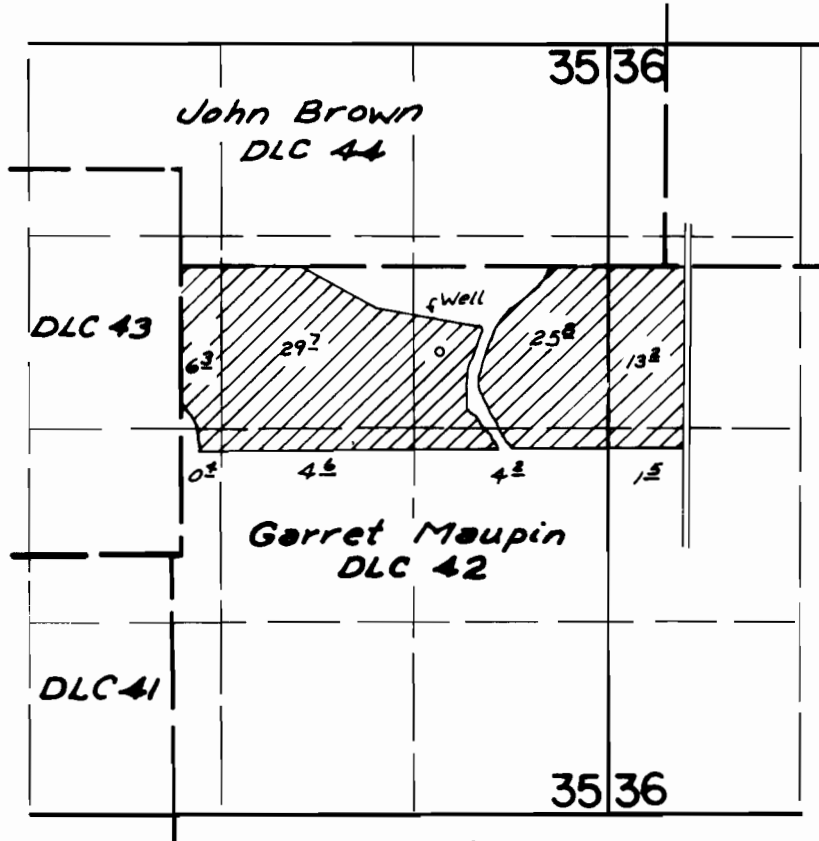

Well Loc: 580' S. of 1770' E., from NW Cor DLC 42

FINAL PROOF SURVEY UNDER

Application No. G-5730 Permit No. G-5530
IN NAME OF

Esther Jane Everson

Surveyed May 14, 1976, by D.M. Norby