


T.16S.,R.4E.,W.M.

21

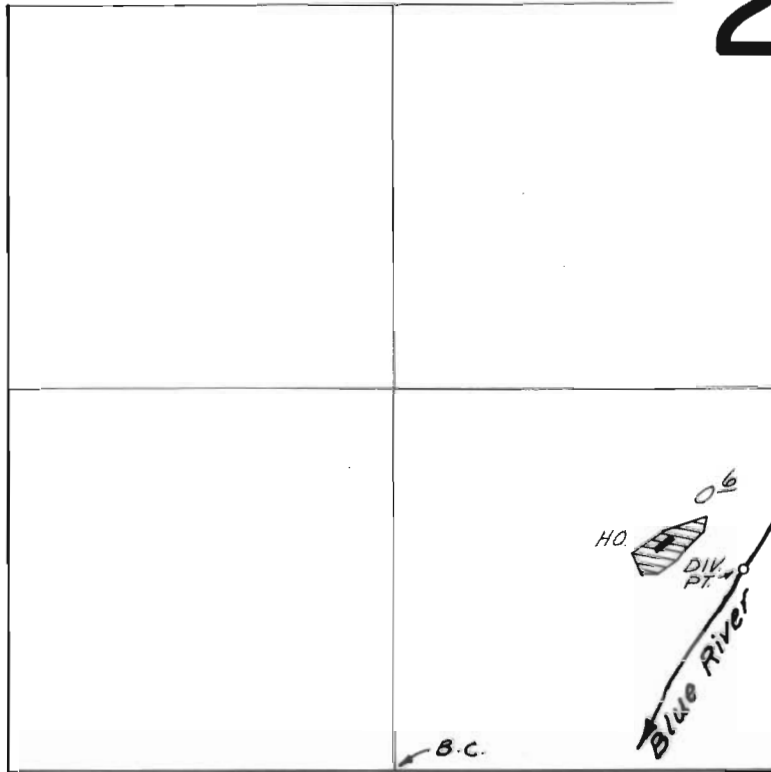

DIV. PT. LOC.: 700' N. & 2520' E. from SW Cor. Sec. 21

SCALE 1" = 660'

FINAL PROOF SURVEY
UNDER

Application No. 39278 Permit No. 29253
IN NAME OF

Fredrick R. Behm

Surveyed May 26 1976, by D.M. Norby

PTS-1976-B *dfb*