


# T.15S. R. 5 W.W.M.

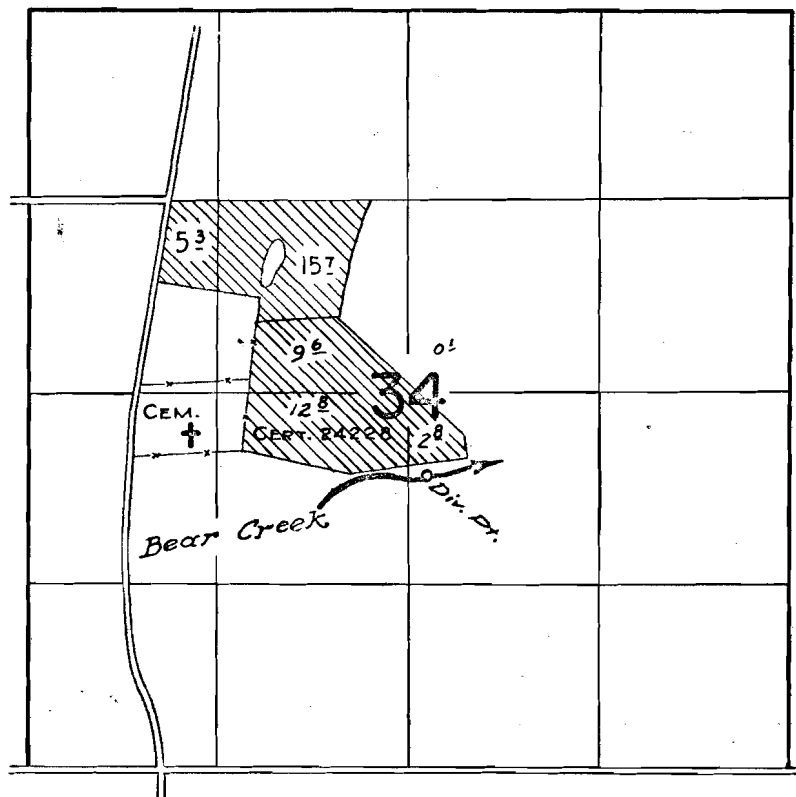

Application No. 44621  
Permit No. 33385

## FINAL PROOF SURVEY UNDER

Application No. ~~32658~~ Permit No. ~~25754~~  
IN NAME OF

ROBERT P. DOERR

Surveyed May 22 1961, by *L. Jackson*