


T.16 S., R.5 E., W.M.

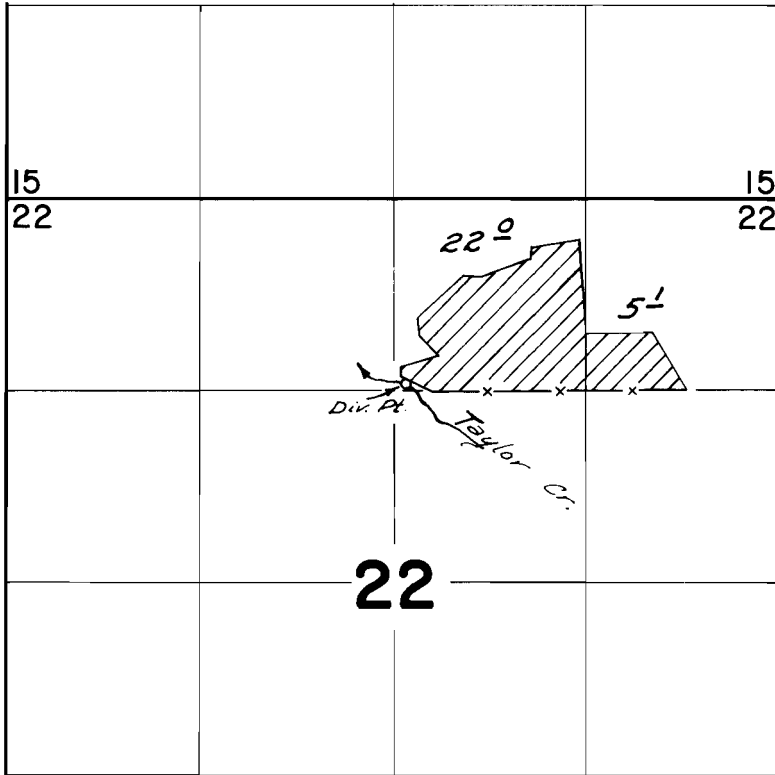

DIV. PT. LOC.: 1250' S. & 80' E. from N. 1/4 Cor. Sec. 22

FINAL PROOF SURVEY
UNDER

Application No. 46088 Permit No. 34396
IN NAME OF

Frederick R. Behm

Surveyed May 26, 1976, by D.M. Norby

PTS-1976-B *LCB*