


T.17S. R.8W. W.M.

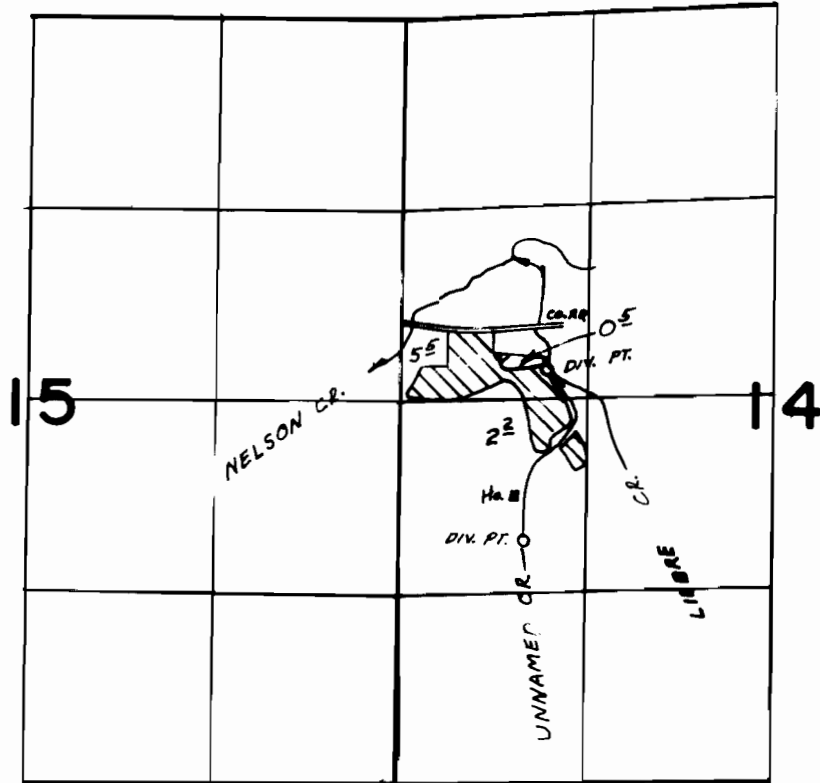

DIV. PTS. LOC. JNN. CR. - 940'S. & 850'E., LIEBRE CR. - 230'N. & 1010'E, BOTH FROM W 1/4 COR. SEC. 14.

▨ LIEBRE CR. ▨ UNN. CR.

FINAL PROOF SURVEY
UNDER

Application No. 49327... Permit No. 36248...
IN NAME OF

CLARENCE BARRETT, JR.

Surveyed MAY 7... 1976, by L.H. NUNN