


T. 16 S., R. 2 W., W.M.

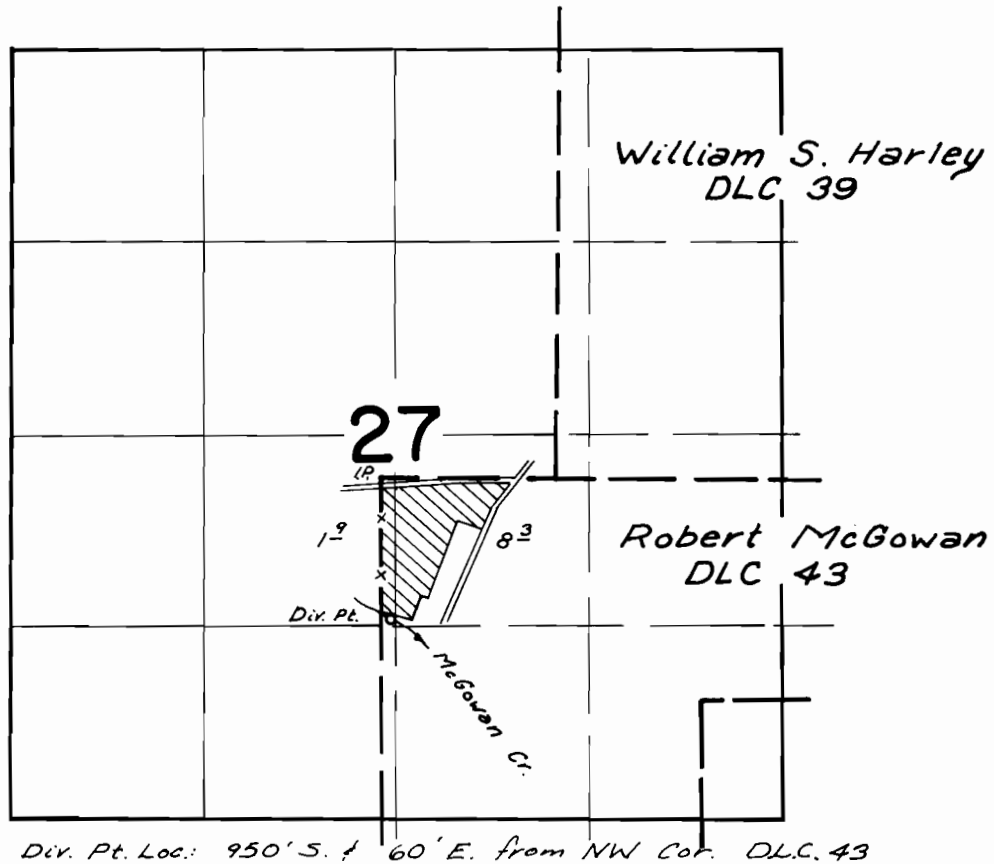

FINAL PROOF SURVEY UNDER

Application No. 53004 Permit No. 40008
IN NAME OF

Hans B. Zimmer

Surveyed Oct 26 1976, by D.M. Norby