


T. 16S., R. 2E., W.M.

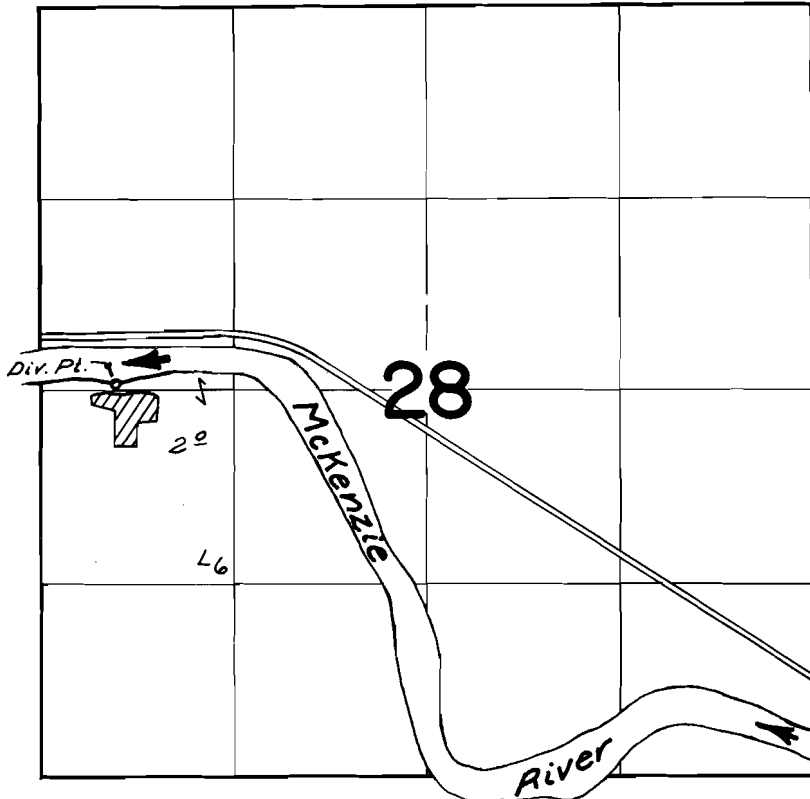

Div. Pt. Loc: 50' N. of 520' E. From W. 1/4 Cor. Sec. 28

FINAL PROOF SURVEY UNDER

Application No. 53215 Permit No. 39489
IN NAME OF

Robert Goodpasture

Surveyed May 27, 1976, by D. M. Norby