


T. 14 S., R. 12 W., W.M.

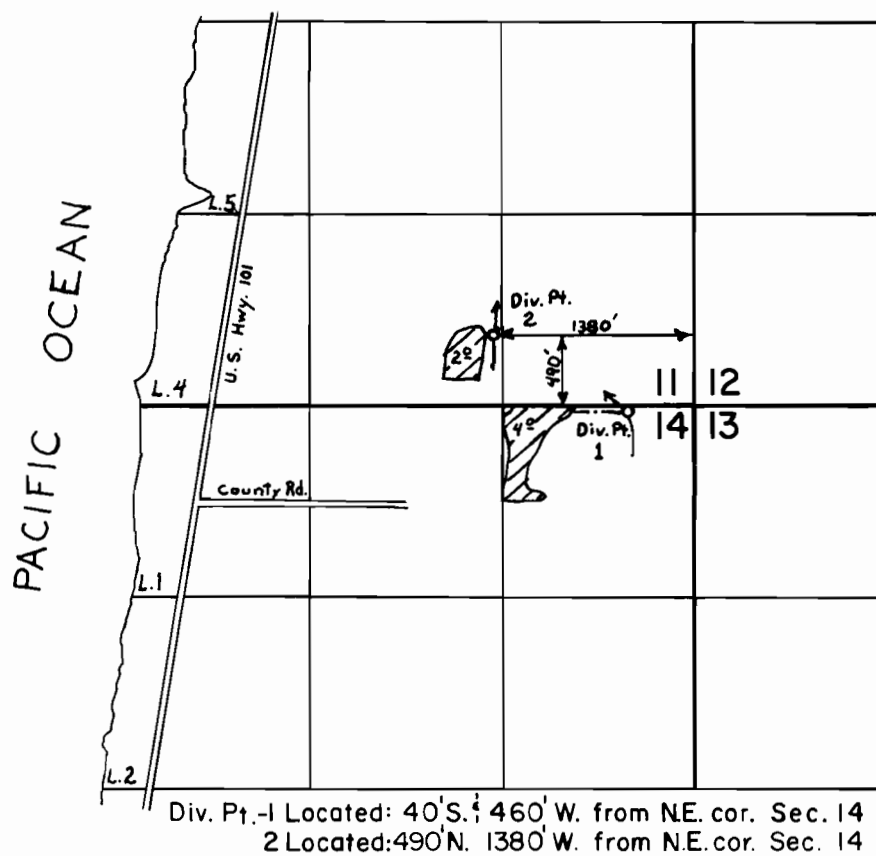

FINAL PROOF SURVEY
UNDER

Application No. 41710 Permit No. 31141
IN NAME OF

GEORGE DOLLOWITCH, SR.

Surveyed AUG. 12 1976, by D. NORBY