


T.14S.,R9W.,W.M.

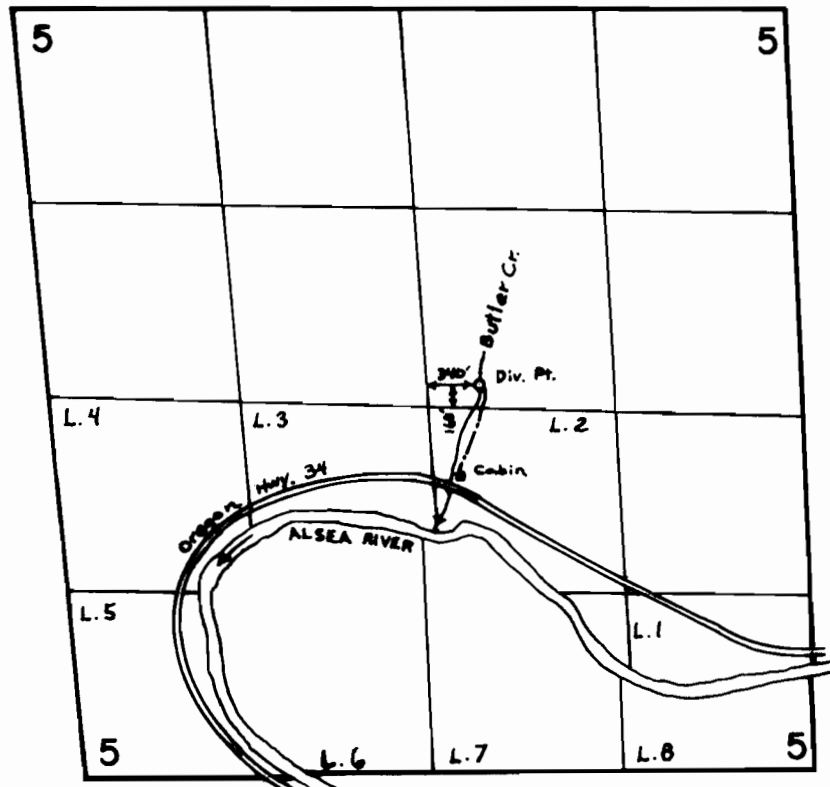

FINAL PROOF SURVEY
UNDER

Application No. 47958 Permit No. 35953
IN NAME OF

STANLEY RAY TAYLOR

Surveyed AUG. 10 1976, by D. NORBY