


T.14 S., R.12 W., W.M.

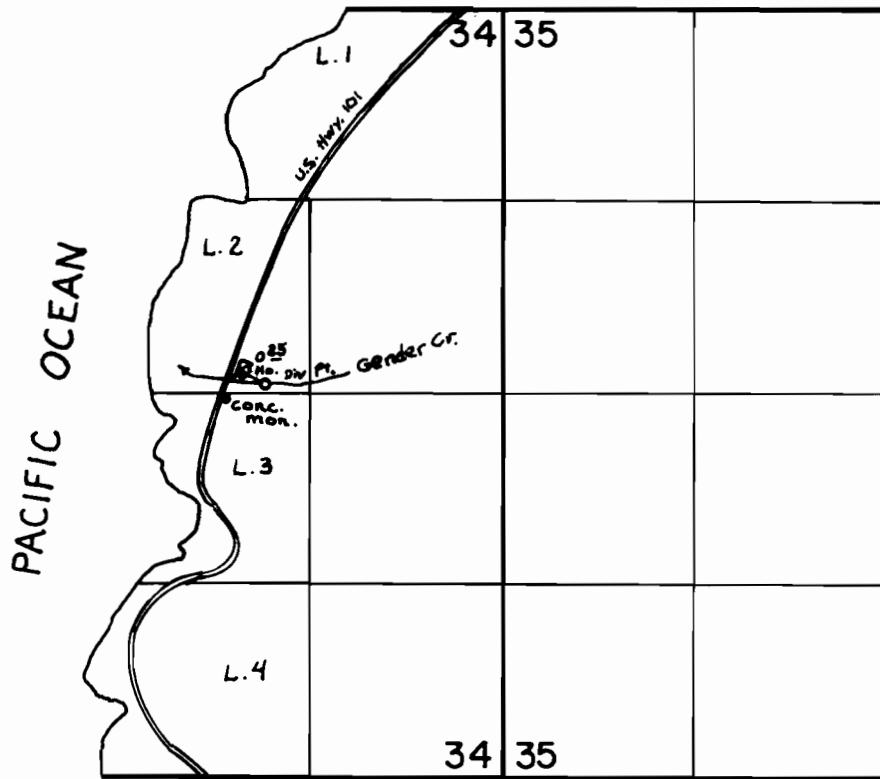

Div. Pt. Located: $60' N. \frac{1}{4} 300' W.$ from the S.E. cor. Lot 2

FINAL PROOF SURVEY UNDER

Application No. 51854 Permit No. 39146
IN NAME OF

ALBERT O. DAHL

Surveyed AUG. 10 1976, by D. NORBY