


T.13S., R.10W., W.M.

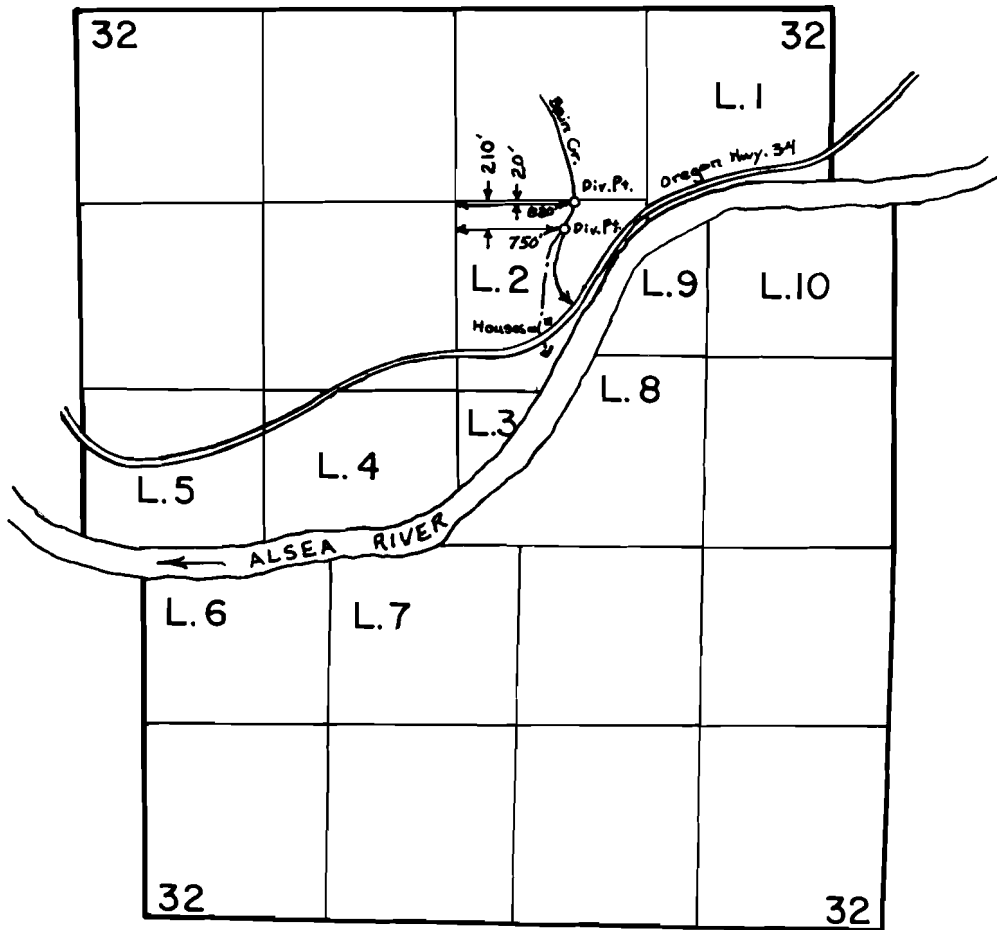

FINAL PROOF SURVEY UNDER

Application No. 53536 Permit No. 40070
IN NAME OF

BRYON D. MEADOWS

Surveyed AUG. 9 1976, by D. NORBY