


T.9S., R.1W., W.M.

SECTION 15

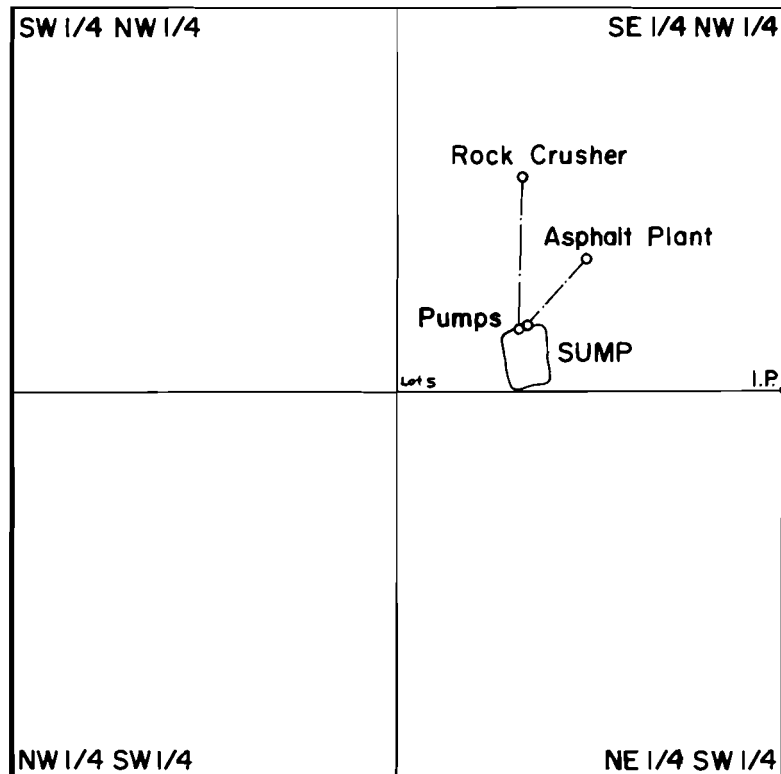

SUMP LOC: 150' N & 900' W from center sec. 15

FINAL PROOF SURVEY UNDER

Application No. G-5589 Permit No. G-5446
IN NAME OF

NORTH SANTIAM SAND & GRAVEL CO.

Surveyed Sept. 10 1976, by D. Norby