


# T.11S., R.4W., W.M.

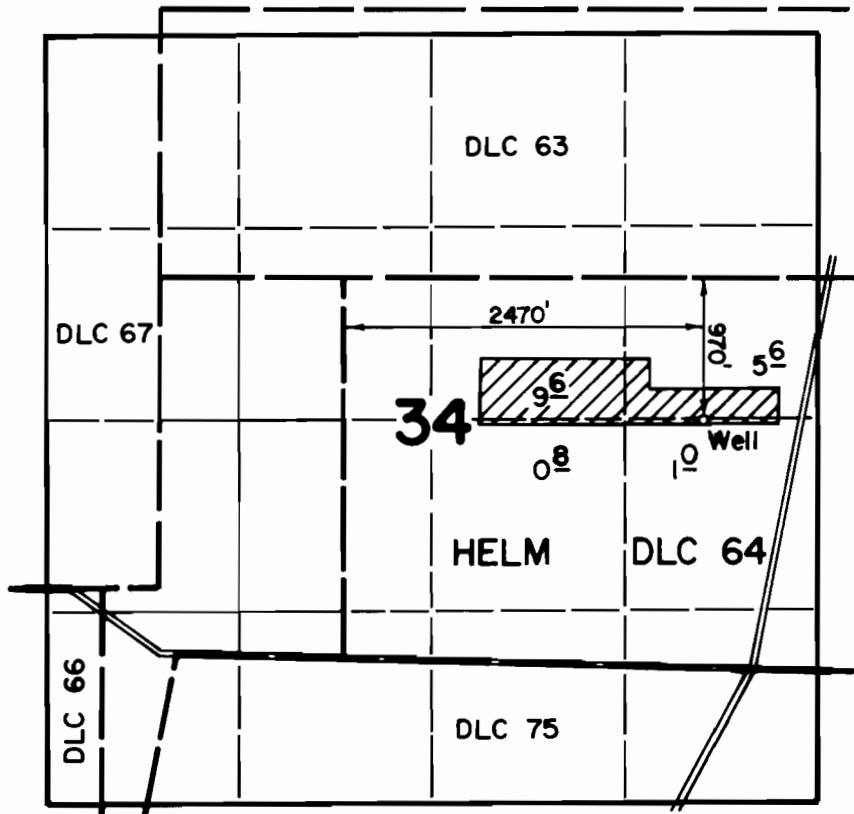

## FINAL PROOF SURVEY UNDER

Application No. G-5989 Permit No. G-5707  
IN NAME OF

ROBERT D. RICHARDS

Surveyed April 15 1976, by D. Norby