


T.10S., R.3W., W.M.

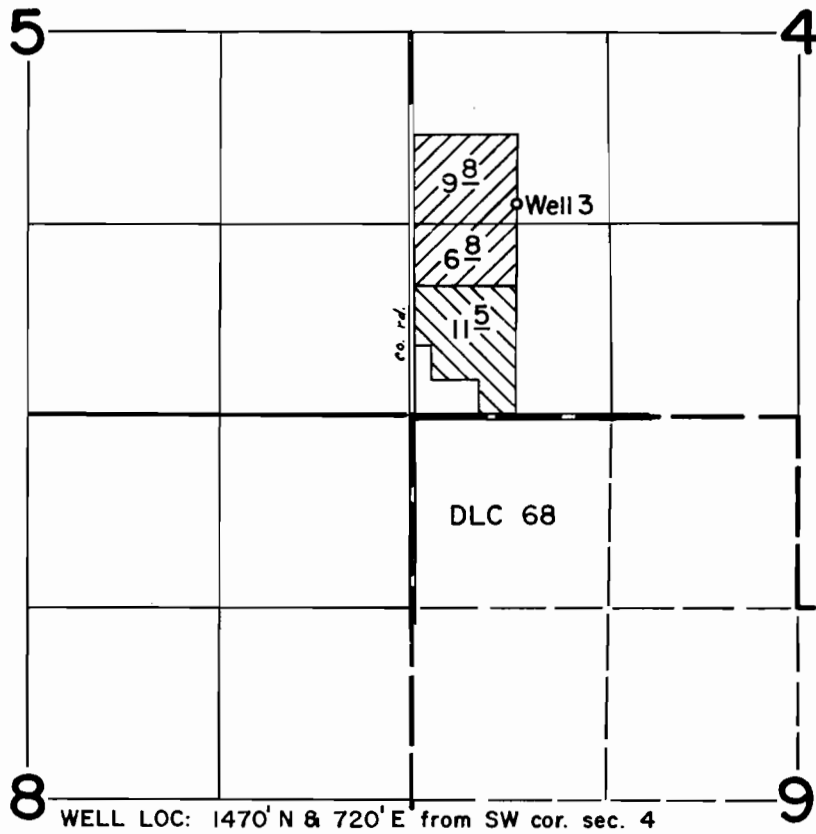

-  Permit G-5711
-  Permit G-6652

FINAL PROOF SURVEY
UNDER

Application No. G-6003 Permit No. G-5711
G-7248 G-6652
IN NAME OF

NORVAN ANDREWS

Surveyed April 12 1976, by D. Norby